IREDELL COUNTY HEALTH DEPARTMENT

STATESVILLE 704-878-5305 MOORESVILLE 704-664-5281

IMPROVEMENT PERMIT / CERTIFICATE OF COMPLETION / OPERATION PERMIT / EXISTING SYSTEM INSPECTION

PROPERTY DESCRIPTION NO. 15325 DATE 6/29/93 TAX MAP NO. 3C 10 14144

OWNER OR CONTRACTOR Young Builders (Broderick Site) PHONE: Business Home 815-8238

ADDRESS Fern Hill Rd Trentmon, NC. 4638 19 3987

LOCATION Fern Hill, TR on Permishtead Rd. TR on Quail Ln. house on (L)

SUBDIVISION BLOCK / SECTION LOT LOT AREA SITE CLASS. L.T.A.R.

Water Supply: ☑ Individual ☐ Community ☐ Public

Septic Tank: 1000 Gallons; STB Date

Pump Tank: 1000 Gallons; PT Date

Nitrification Field: No Fields 1 Square Feet ~625 Linear Feet 125'

No Lines 3 Trench Width 36-48" Trench Depth 7.5' Gravel Depth 12"

☐ New System ☑ Repair System Type: I, II, (III), IV, V, VI

System Description: CONV.

Repair System Description: CONV-PRESSURE

Maintenance Agreement Required: ☑ Yes ☐ No

☑ House/Mod. Home No. Bedrooms 3 Garbage Disposal: ☐ Yes ☑ No

☐ Mobile Home No. Bathrooms 2 Auto. Dishwasher: ☑ Yes ☐ No

☐ Business No. Employees Auto. Washing Machine: ☑ Yes ☐ No


☐ Other Other

☐ Slab ☐ Crawl Space ☐ Basement w/plumbing ☑ Basement wo/plumbing

Comments

INITIAL SITE SKETCH

AS BUILT SKETCH

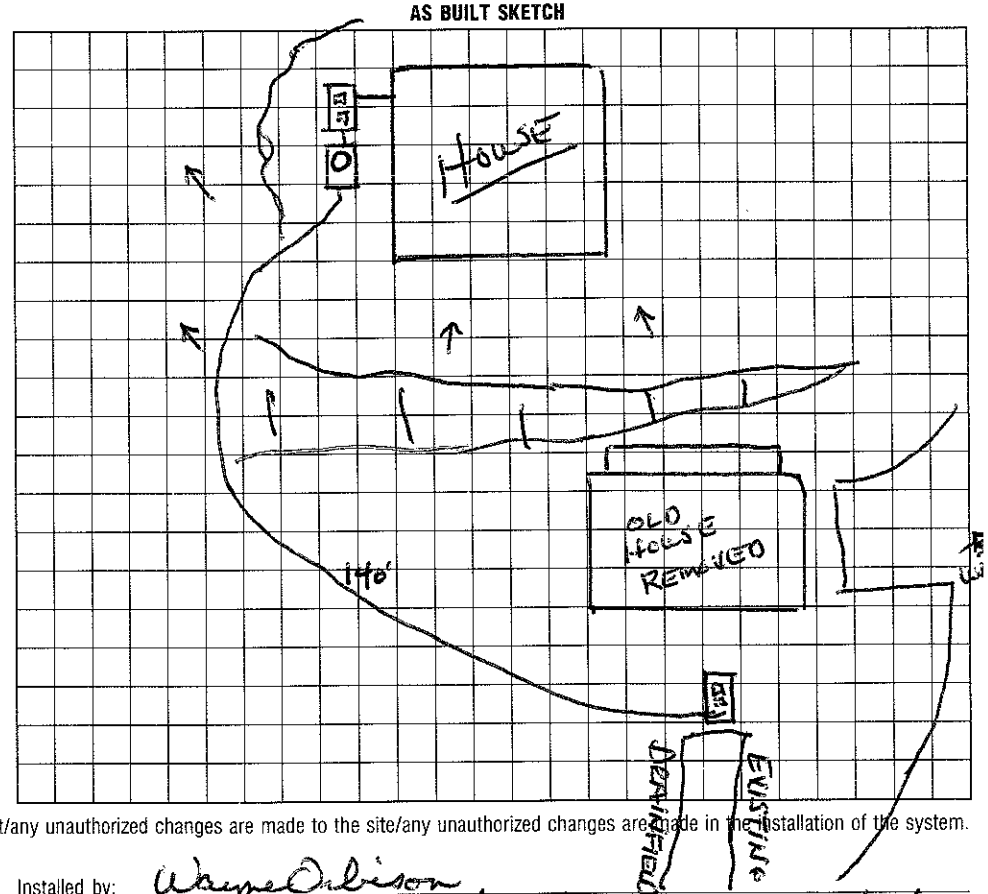

I understand that this permit can be suspended or revoked if any false information is supplied toward securing the permit/any unauthorized changes are made to the site/any unauthorized changes are made in the installation of the system. Improvement Permit is valid for 60 months from date of issuance.

Signed:

Improvement Permit by: date

Existing System Inspection by: date

Installed by: Wayne Osbison

Certificate of Completion by: Wesley Sparks R.S. date 6/29/93

Operation Permit by: date

HEALTH DEPT. COPY: WHITE INSPECTION COPY (FINAL): GREEN OWNER COPY (FINAL): YELLOW INSPECTION COPY (INITIAL): PINK OWNER COPY (INITIAL): GOLD