IREDELL COUNTY HEALTH DEPARTMENT

STATESVILLE 704-878-5305 MOORESVILLE 704-664-5281

IMPROVEMENT PERMIT / AUTHORIZATION TO CONSTRUCT / OPERATION PERMIT / EXISTING SYSTEM INSPECTION

3.00

PERMIT# 079615 PIN# 4638 21 ~~2480~~ 1440 DATE 5/14/99

OWNER OR CONTRACTOR Angela Elmore PHONE: Business Home 875-6655

ADDRESS 1120 McCoy Rd. Huntersville, NC. 28078

LOCATION 150 W TR Robinson Rd. TL Rustic Way to 2ND + 3RD lots on (L)

SUBDIVISION East Lake BLOCK / SECTION LOT 13+14 LOT AREA 1 AC TOTAL SITE CLASS. PS DESIGN FLOW 360 L.T.A.R. .3

Septic Tank: 1000 Gallons; STB 714 Date 2/24/99
Pump Tank: Gallons; PT Date
Pump Make: Model Serial No.
Nitrification Field: No Fields 1 Square Feet 900* Linear Feet 300*
No Lines 4@75' 3' Trench Width 36" Max Trench Bottom Depth 36" Gravel Depth SAND

[X] New System [ ] Repair System Type: I, II, [III], IV, V, VI
System Description: Gravity-CH Plastic
Repair System Description: Same
Maintenance Agreement Required: [ ] Yes [X] No

[X] House/Mod. Home No. Bedrooms 3
[ ] Mobile Home No. Bathrooms 2
[ ] Business No. Employees
[ ] Other


[ ] Slab [X] Crawl Space [ ] Basement w/plumbing [ ] Basement wo/plumbing

Water Supply: [X] Individual [ ] Public [ ] Community

Comments:/Conditions:


1" = 50'

INITIAL SITE SKETCH

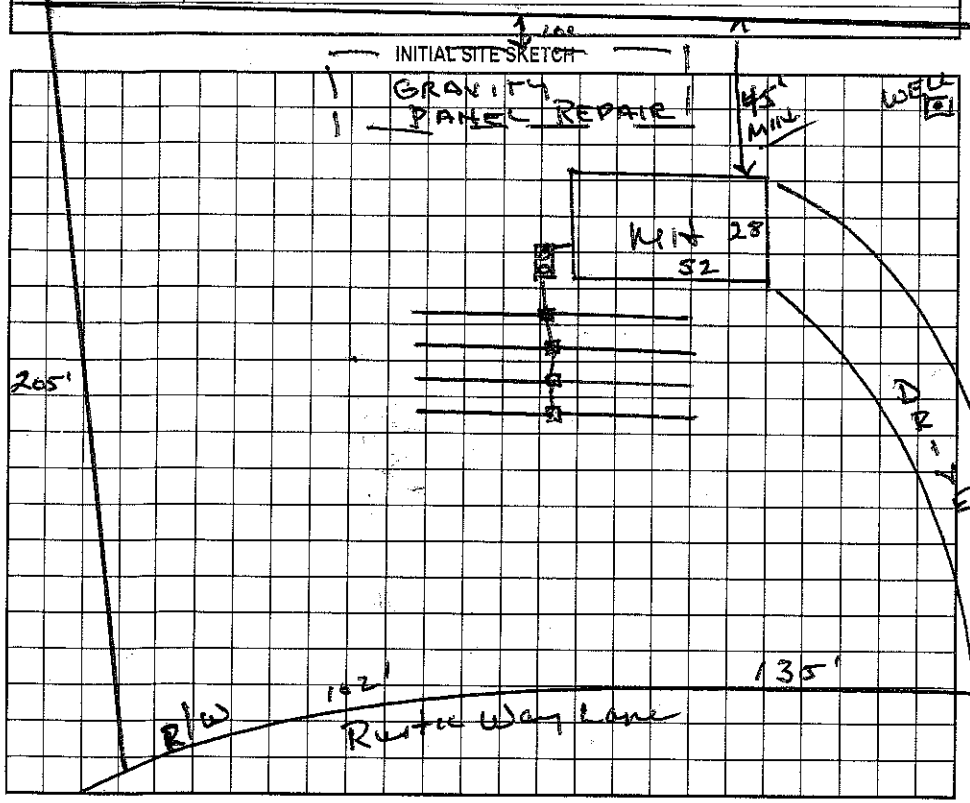

Comments:/Conditions:

AS BUILT SKETCH

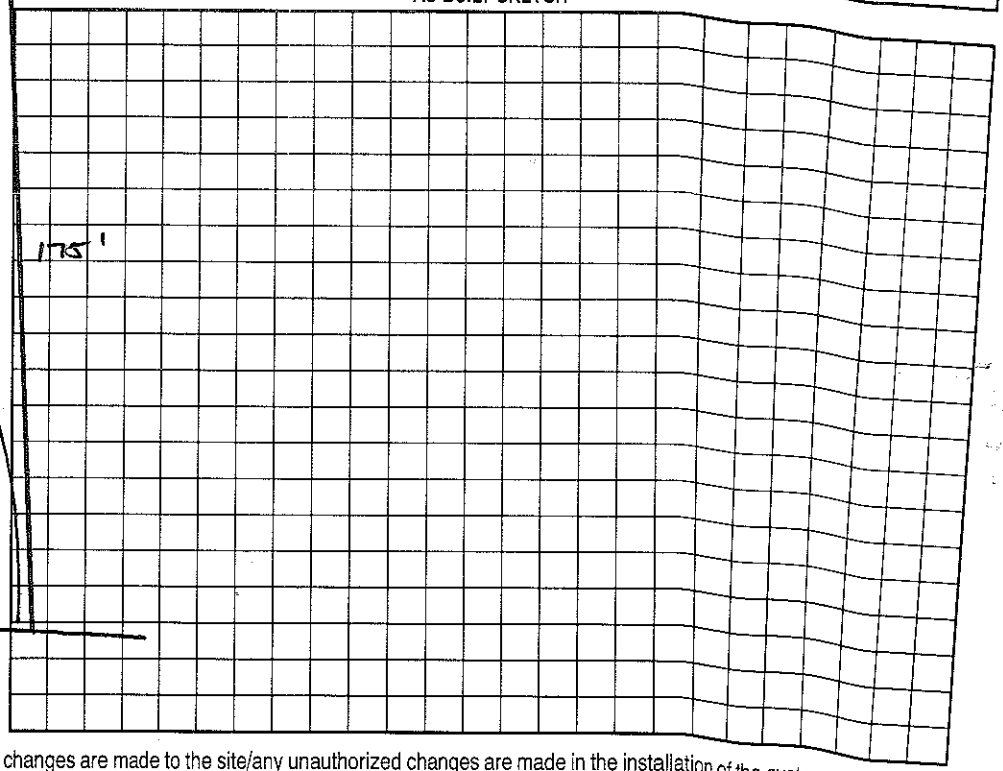

Permit can be suspended or revoked if any false information is supplied toward securing the permit/any unauthorized changes are made to the site/any unauthorized changes are made in the installation of the system. Improvement Permit with plat valid without expiration. Improvement Permit with site plan valid for sixty months. Authorization to Construct is valid for a period equal to that of Improvement Permit – not to exceed sixty months.

Signed: *Angela B. Elmore date 5-14-99

Improvement Permit by: Wesley Sparks RS. date 5/14/99

Authorization to Construct by: Wesley Sparks RS. date 5/14/99

Installed by: Buddy Chaney

Operation Permit by: C. [illegible] RS date 5/14/99

Existing System Inspection by: date

HEALTH DEPT. COPY: WHITE OWNER COPY (FINAL): YELLOW OWNER COPY (INITIAL): PINK