IREDELL COUNTY HEALTH DEPARTMENT

STATESVILLE 704-878-5305 MOORESVILLE 704-664-5281

IMPROVEMENT PERMIT / AUTHORIZATION TO CONSTRUCT / OPERATION PERMIT / EXISTING SYSTEM INSPECTION

3:00

PERMIT# 111859 PIN# 4638220921 DATE 3-1-07

OWNER OR APPLICANT Eric Hustfeld PHONE: Business 622-5573 Home

ADDRESS P.O. Box 3983 Mooresville, NC 28117

LOCATION Hwy 150 W TR Robinson Rd at end on right

SUBDIVISION RobinsonWoods BLOCK / SECTION LOT 25 LOT AREA 1.28 Acre SITE CLASS. RS DESIGN FLOW 600gpd L.T.A.R. e 3

Septic Tank: 1500 Gallons; STB 338 Date 3-18-07

Pump Tank: Gallons; PT Date

Pump Make: Model Serial No.

Nitrification Field: No Fields 1 Square Feet 1500 Linear Feet 500'

No Lines ~~See Plot~~ Trench Width 36" Max Trench Bottom Depth 36" Gravel Depth N/A

☒ New System ☐ Repair ☐ Expansion System Type: I II III IV V VI

System Description: Gravity - 25% Reduction

Repair System Description: Same

Maintenance Agreement Required: ☐ Yes ☒ No

☒ House/Mod. Home No. Bedrooms 5

☐ Mobile Home No. Persons

☐ Business No. Employees

☐ Other

Water Supply: ☒ Individual ☐ Public ☐ Community


☒ Gravity ☐ Pressure ☐ Slab ☒ Crawl Space ☐ Basement w/plumbing ☐ Basement wo/plumbing

Comments/Conditions: Note: Future pool must be at least 15ft from Septic System & 10ft from Supply line.

Comments/Conditions: This permit replaces previous permit from 9/6/06 Drainline start 45ft off ST Installed Quick 4 for Drainfield in 6 lines

Scale 1:50 INITIAL SITE SKETCH

AS BUILT SKETCH

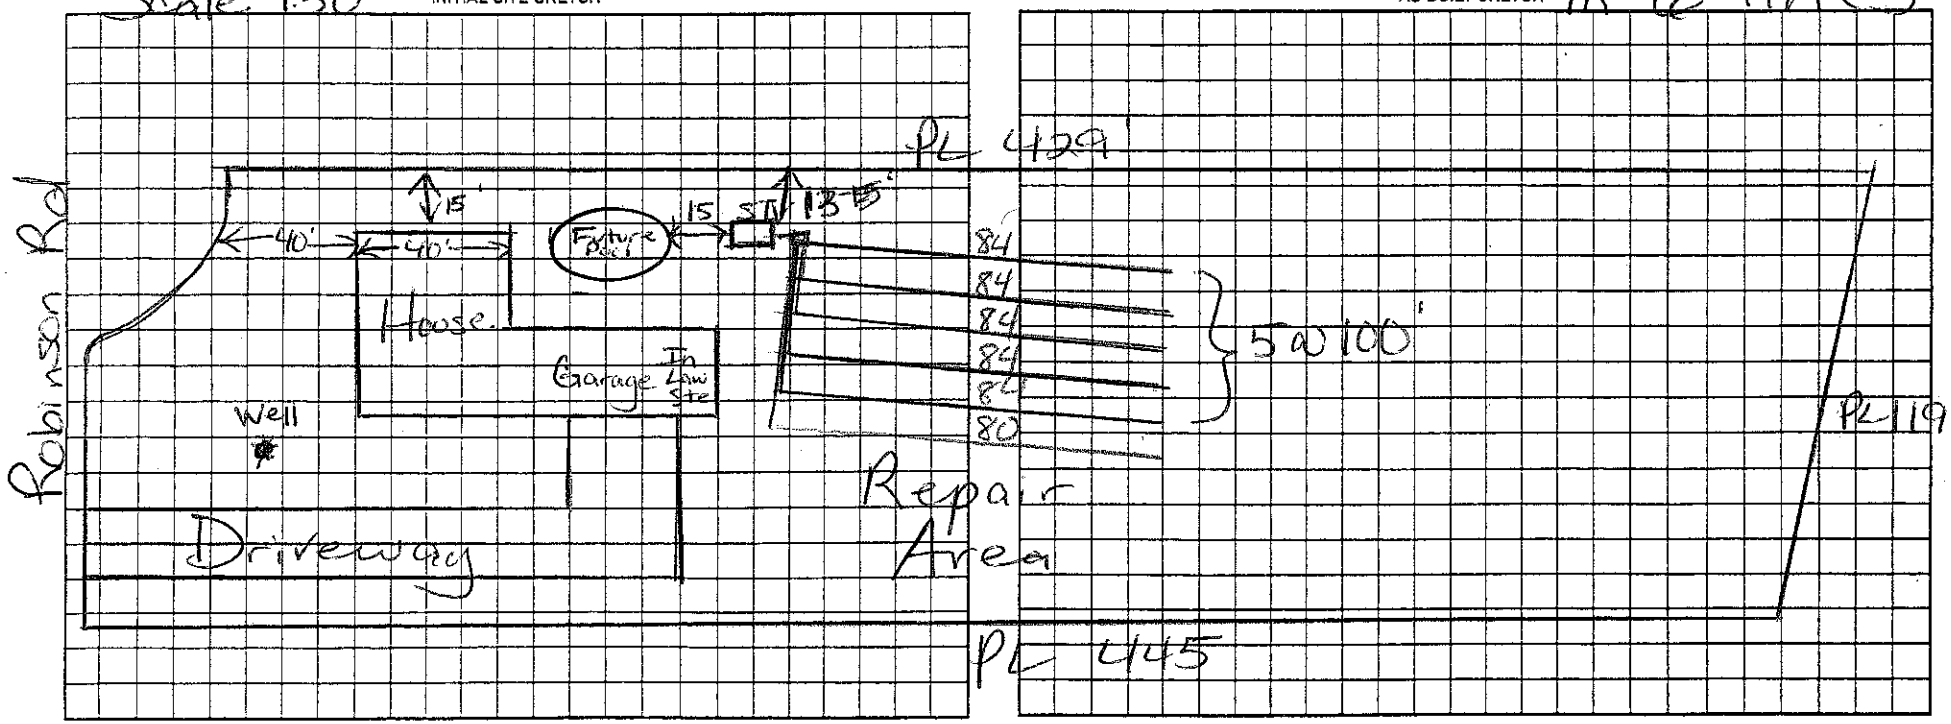

Permit can be suspended or revoked if any false information is supplied toward securing the permit/any unauthorized changes are made to the site/any unauthorized changes are made in the installation of the system. Improvement Permit with plat valid without expiration ☐ Improvement Permit with site plan valid for sixty months ☐ Authorization to Construct is valid for a period equal to that of Improvement Permit – not to exceed sixty months.

Signed: date 3/1/07

Improvement Permit by: Maina M. Dolan RS date 3/1/07

Authorization to Construct by: Maina M. Dolan RS date 3/1/07

Installed by: Larry Pecan RS

Operation Permit by: Maina M. Dolan RS date 4/1/07

Existing System Inspection by: date

HEALTH DEPT. COPY: WHITE OWNER COPY (FINAL): YELLOW OWNER COPY (INITIAL): PINK