IREDELL COUNTY HEALTH DEPARTMENT

STATESVILLE 704-878-5305 MOORESVILLE 704-664-5281

IMPROVEMENT PERMIT / CERTIFICATE OF COMPLETION / OPERATION PERMIT / EXISTING SYSTEM INSPECTION

PROPERTY DESCRIPTION NO. 15926 DATE 9/22/93 4638226996 TAX MAP NO. 2P-4-A-154

OWNER OR CONTRACTOR ABT CONST (CURTIS GUILD) PHONE: Business 664-4353 Home

ADDRESS R#9 Box 425 MOORESVILLE

LOCATION NORMANDY RD, TR CUL DE SAC ON (R) BELOW ROAD

SUBDIVISION CL+T BLOCK / SECTION 11 LOT 1107 LOT AREA ~1.02 AC SITE CLASS. P L.T.A.R. .3

Water Supply: ☑ Individual ☐ Community ☐ Public

Septic Tank: 1000 Gallons; STB 794 Date 8/1/93

Pump Tank: 1000 Gallons; PT 727 Date 8/15/93

Nitrification Field: No Fields 1 Square Feet Linear Feet 200

No Lines 3 Trench Width 2' Trench Depth 36" Gravel Depth 6" STONE

☑ New System ☐ Repair System Type: I, II, (III) IV, V, VI

System Description: PP BRS - Pump

Repair System Description: PABAS - GRAVITY

Maintenance Agreement Required: ☑ Yes ☐ No

☑ House/Mod. Home ☐ Mobile Home ☐ Business ☐ Other

No. Bedrooms 3 No. Bathrooms 3 No. Employees

Garbage Disposal: ☐ Yes ☑ No

Auto. Dishwasher: ☑ Yes ☐ No

Auto. Washing Machine: ☑ Yes ☐ No


Other

☐ Slab ☑ Crawl Space ☐ Basement w/plumbing ☐ Basement wo/plumbing

Comments 9/22/93 Waiting for alarm Cert and NEMA 4X box to be finished & AWS to

INITIAL SITE SKETCH

AS BUILT SKETCH

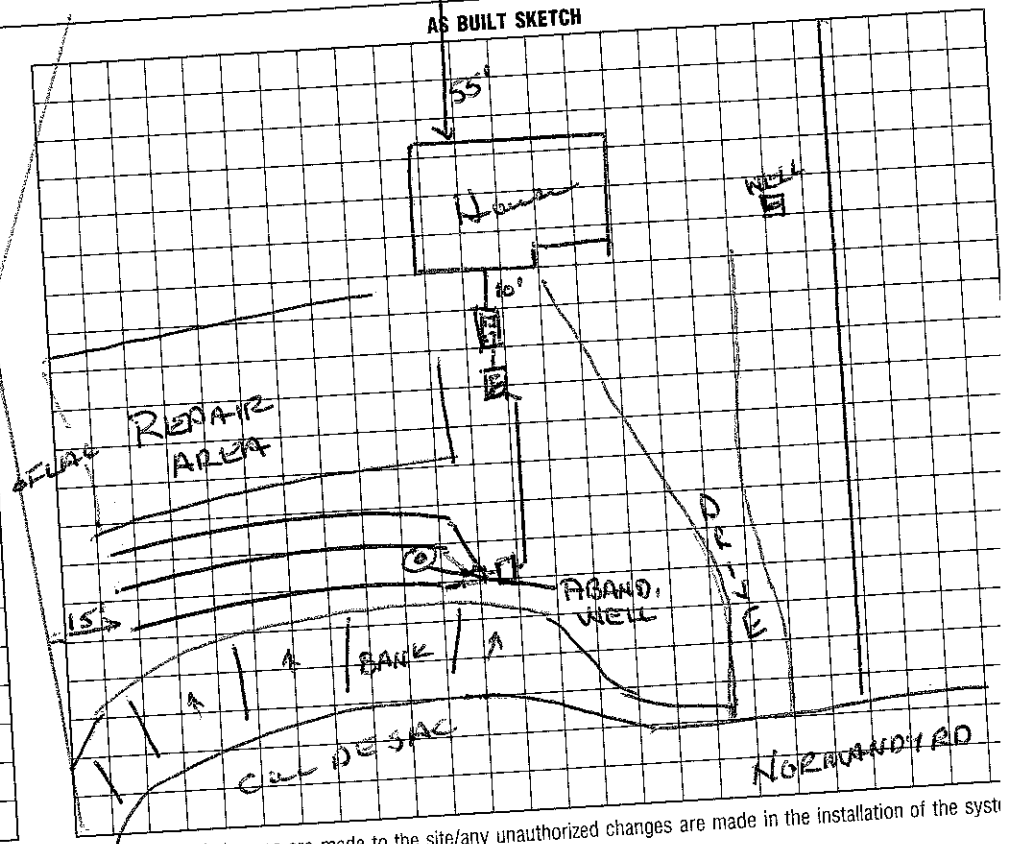

...can be suspended or revoked if any false information is supplied toward securing the permit/any unauthorized changes are made to the site/any unauthorized changes are made in the installation of the syst...
...the from date of issuance.

Installed by: J Bowles Wesley Sparks RS date 11/18/93

Certificate of Completion by: date

Operation Permit by: date

...YELLOW INSPECTION COPY (INITIAL): PINK OWNER COPY (INITIAL): GOLD