IREDELL COUNTY HEALTH DEPARTMENT

AUTHORIZATION TO CONSTRUCT

STATESVILLE 704-878-5305 MOORESVILLE 704-664-5281

IMPROVEMENT PERMIT / ~~CERTIFICATE OF COMPLETION~~ / OPERATION PERMIT / EXISTING SYSTEM INSPECTION

PROPERTY DESCRIPTION NO. 070003 DATE 11/20/97 TAX MAP NO. 4638228641 Watershed: ☑ ~~Yes~~ ☐ No

OWNER OR CONTRACTOR CRAIG DUBOIS PHONE: Business _____ Home 663-1099

ADDRESS 709 NORMANDY RD - MOORESVILLE

LOCATION PERTH N- TL NORMANDY - AT VERY END

SUBDIVISION _____ BLOCK / SECTION — LOT ~~3~~ LOT AREA 3.73 SITE CLASS. PS DESIGN FLOW 240+ 360 L.T.A.R. .3

Septic Tank: 1000 Gallons; STB 794 Date 3/16/98

Pump Tank: 1000 Gallons; PT 27 Date 4/6/98

Pump Make: HYDROMATIC Model SHEFSDA1 Serial No. N/A

Nitrification Field: No Fields 1 Square Feet @ 600 Linear Feet 500

No Lines 2@100' Trench Width 36" Max Trench Bottom Depth 36" Gravel Depth N/A

☑ New System ☐ Repair System Type: I, II, (III) IV, V, VI

System Description: PUMP CHAMBERED OR HDS

Repair System Description: SAME

Maintenance Agreement Required: ☐ Yes ☑ No

☑ House/Mod. Home No. Bedrooms 2+3

☐ Mobile Home No. Bathrooms ____

☐ Business No. Employees ____

☐ Other _____


☐ Slab ☑ Crawl Space ☐ Basement w/plumbing ☐ Basement wo/plumbing

Water Supply: ☑ Individual ☐ Community ☐ Public


Comments:

Comments:

INITIAL SITE SKETCH

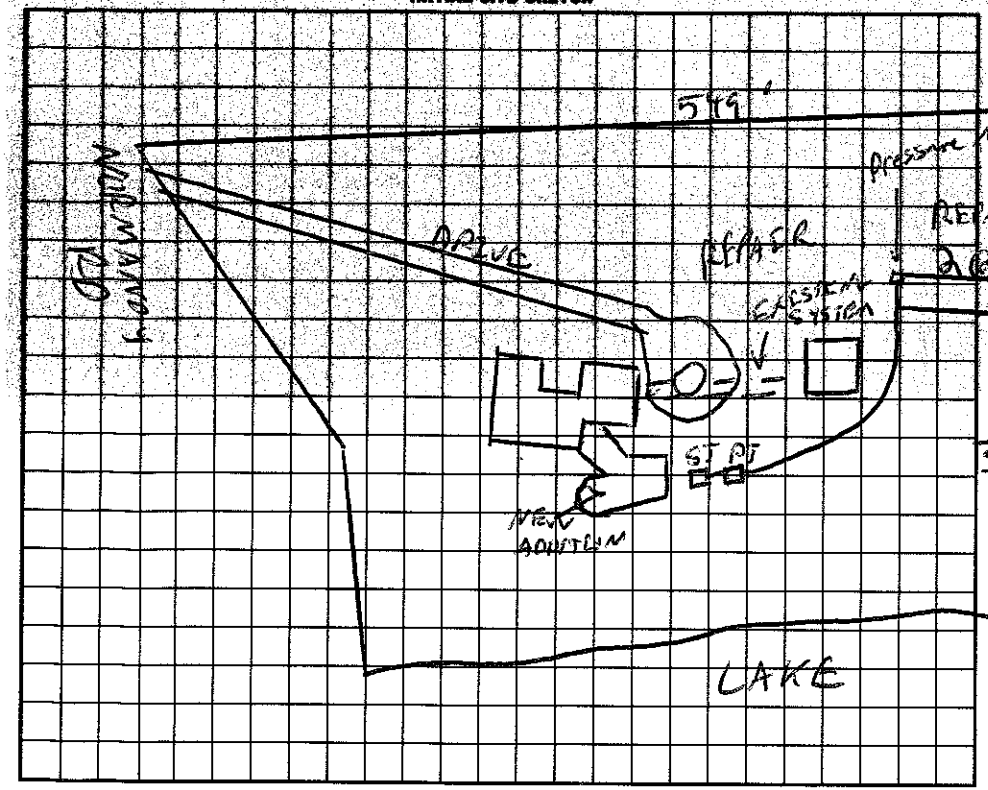

AS BUILT SKETCH

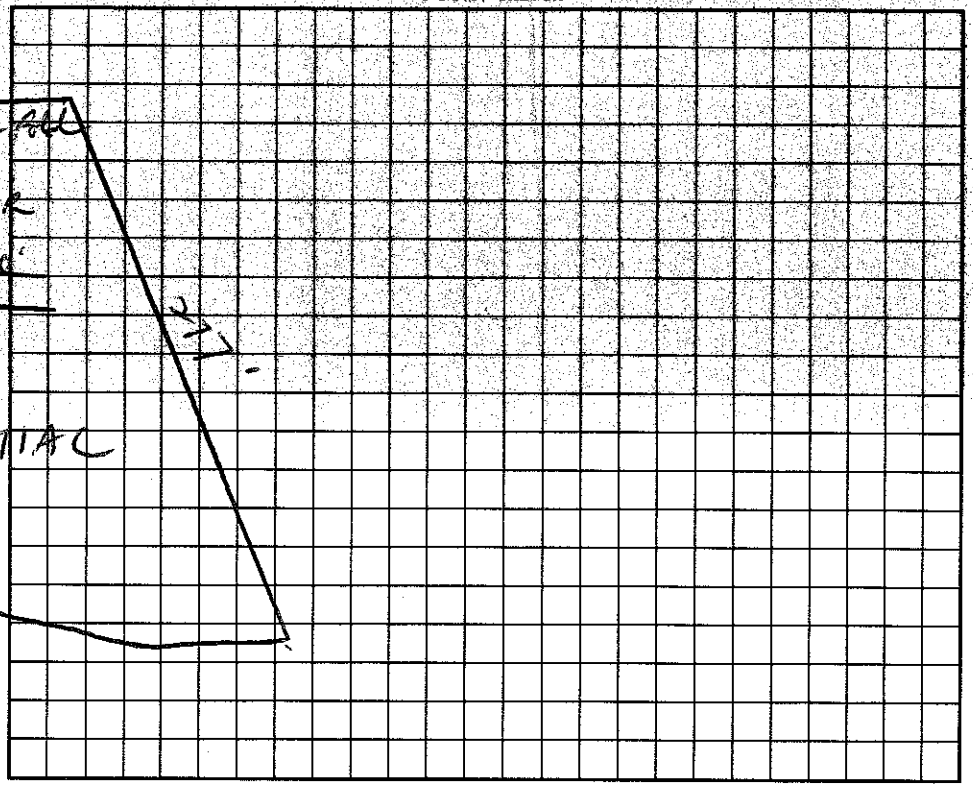

I understand that this permit can be suspended or revoked if any false information is supplied toward securing the permit/any unauthorized changes are made to the site/any unauthorized changes are made in the installation of the system. Improvement Permit is valid for 60 months from date of issuance.

Signed: _____

Improvement Permit by: C Ray Freeman RS date 11/20/97

AUTHORIZATION TO CONSTRUCT ~~Existing System Inspection by:~~ C Ray Freeman RS date 11/20/97

Installed by: _____

Certificate of Completion by: _____ date _____

Operation Permit by: Wesley Sparks RS. date 10/7/98

HEALTH DEPT. COPY: WHITE INSPECTION COPY (FINAL): GREEN OWNER COPY (FINAL): YELLOW INSPECTION COPY (INITIAL): PINK OWNER COPY (INITIAL): GOLD