IREDELL COUNTY HEALTH DEPARTMENT

STATESVILLE 704-878-5305 MOORESVILLE 704-664-5281

IMPROVEMENT PERMIT / CERTIFICATE OF COMPLETION / OPERATION PERMIT / EXISTING SYSTEM INSPECTION

PROPERTY DESCRIPTION NO. 1929 | DATE 9/1/94 | TAX MAP NO. 2P - 4 - A - 153 | Watershed: ☐ Yes ☒ No

OWNER OR CONTRACTOR Michael A Lyon | PHONE: Business 4638-23-6270 | Home 663-1723

ADDRESS 698 Normandy Rd, Mooresville, NC. 28115

LOCATION Normandy Rd. first house on (R) before cul de sac.

SUBDIVISION C-L+T | BLOCK / SECTION 11 | LOT 1106 | LOT AREA ~.9AC | SITE CLASS. P | DESIGN FLOW 360 | L.T.A.R. .3

Septic Tank: 1520 Gallons; STB _____ Date _____

Pump Tank: 1520 Gallons; PT _____ Date _____

Pump Make: _____ Model Existing Serial No: _____

Nitrification Field: No Fields 1 Square Feet 1215 Linear Feet 405

No Lines 3 Trench Width 3 Max Trench Bottom Depth 30-52 Gravel Depth _____

☐ New System ☐ Repair System Type: I, II, III, IV, V, VI

System Description: Pressure-Conv.

Repair System Description: _____

Maintenance Agreement Required: ☐ Yes ☐ No

☒ House/Mod. Home No. Bedrooms 3

☐ Mobile Home No. Bathrooms 3

☐ Business No. Employees _____

☐ Other _____

☐ Slab ☐ Crawl Space ☒ Basement w/plumbing ☐ Basement wo/plumbing

Water Supply: ☒ Individual ☐ Community ☐ Public


Comments:

Comments: No evidence of malfunction

WELL

INITIAL SITE SKETCH

AS BUILT SKETCH

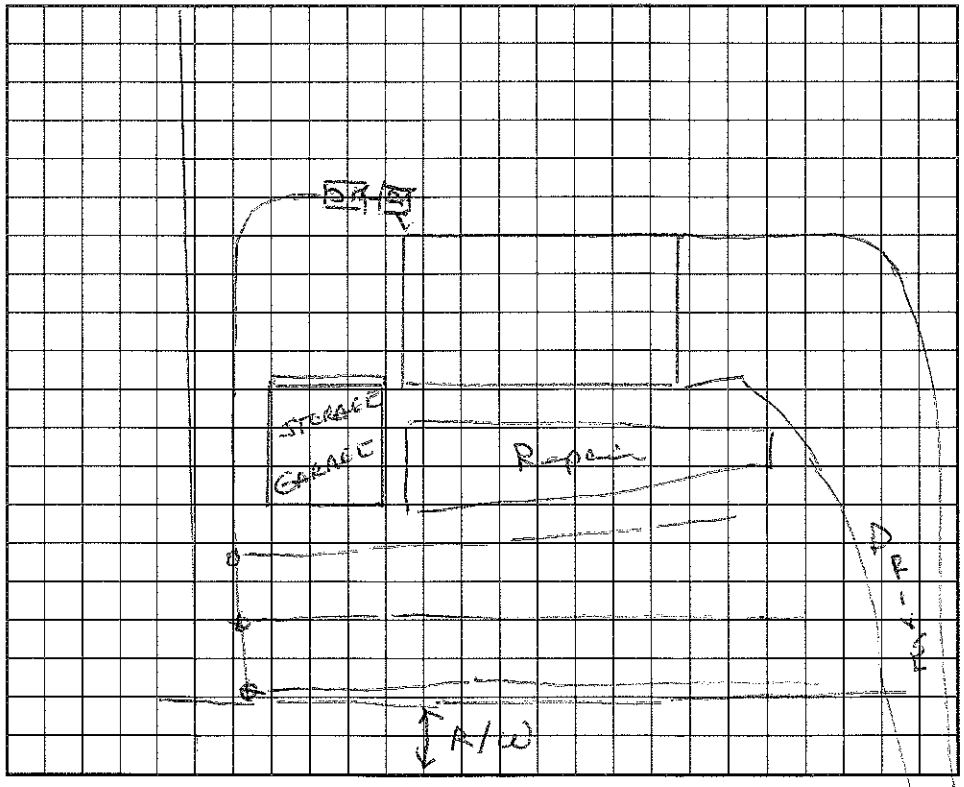

I understand that this permit can be suspended or revoked if any false information is supplied toward securing the permit/any unauthorized changes are made to the site/any unauthorized changes are made in the installation of the system. Improvement Permit is valid for 60 months from date of issuance.

Signed: _____

Improvement Permit by: _____ date _____

Existing System Inspection by: Wesley Sparks R.S. date 9/1/94

Installed by: _____

Certificate of Completion by: _____ date _____

Operation Permit by: _____ date _____

HEALTH DEPT. COPY: WHITE | INSPECTION COPY (FINAL): GREEN | OWNER COPY (FINAL): YELLOW | INSPECTION COPY (INITIAL): PINK | OWNER COPY (INITIAL): GOLD