IREDELL COUNTY HEALTH DEPARTMENT

STATESVILLE 704-878-5305 MOORESVILLE 704-664-5281

IMPROVEMENT PERMIT / CERTIFICATE OF COMPLETION / OPERATION PERMIT / EXISTING SYSTEM INSPECTION

PROPERTY DESCRIPTION NO. 13729 DATE 9/26/94 TAX MAP NO. 2P-13-A-4 4638 23 9525 Watershed: ☐ Yes ☒ No

OWNER OR CONTRACTOR Charles Dorsin PHONE: Business _____ Home 664-3171

ADDRESS 684 Normandy Rd. Mooresville, NC. 28115

LOCATION Normandy Rd. 2 miles on (L) from Perth Rd.

SUBDIVISION Normandy Hills BLOCK / SECTION _____ LOT 4 LOT AREA .49 Ac SITE CLASS. 7 DESIGN FLOW 360 L.T.A.R. .3

Septic Tank: 1000 Gallons; STB 294 Bellinger Date 4-25-95

Pump Tank: 1000 Gallons; PT 27 Date 9-4-95

Pump Make: _____ Model _____ Serial No. 300 4HP

Nitrification Field: No Fields 1 Square Feet 1200 Linear Feet ~~400~~

No Lines 4 Trench Width 3 Max Trench Bottom Depth 32" Gravel Depth 12"

☑ New System ☐ Repair System Type: I, II, (III), IV, V, VI

System Description: PRESS MANIFOLD - PRESS LINES

Repair System Description: PANEL - PRESSURE

Maintenance Agreement Required: ☑ Yes ☐ No 5 YRS

☑ House/Mod. Home No. Bedrooms 3

☐ Mobile Home No. Bathrooms 2.5

☐ Business No. Employees ____

☐ Other _____


☐ Slab ☐ Crawl Space ☐ Basement w/plumbing ☑ Basement wo/plumbing

Water Supply: ☑ Individual ☐ Community ☐ Public

Comments: 3/4 Basement - 2FT HEAD - 50 GAL/DOSE - 3" DRAWDOWN PER DOSE
3/16" Hole on 5 foot centers - Pressure Manifold Distribution
1½" PVC in drainfield - Stay on contour!

Comments: 10/2/95 - Changed to 300' of subsoil trench.

INITIAL SITE SKETCH

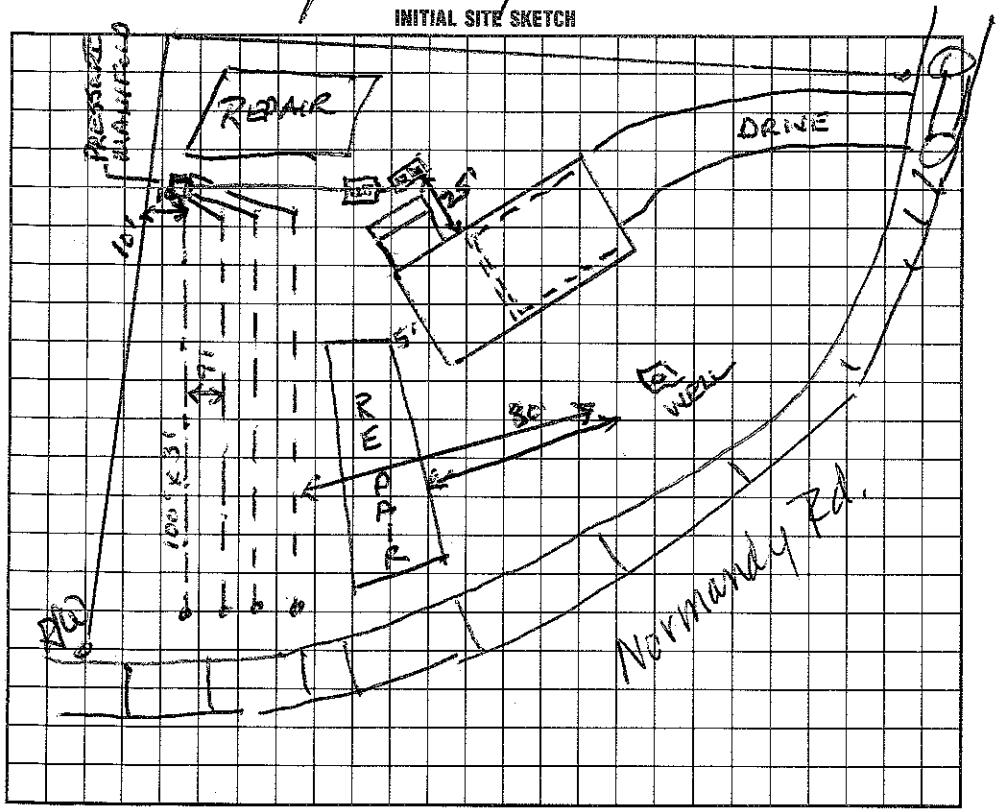

AS BUILT SKETCH

I understand that this permit can be suspended or revoked if any false information is supplied toward securing the permit/any unauthorized changes are made to the site/any unauthorized changes are made in the installation of the system. Improvement Permit is valid for 60 months from date of issuance.

Signed: C W Gordin

Improvement Permit by: Wesley Sparks RS. date _____

Existing System Inspection by: _____ date _____

Installed by: Wes Lytton

Certificate of Completion by: Wesley Sparks RS. date 11/21/95

Operation Permit by: Wesley Sparks RS. date 11/21/95

HEALTH DEPT. COPY: WHITE INSPECTION COPY (FINAL): GREEN OWNER COPY (FINAL): YELLOW INSPECTION COPY (INITIAL): PINK OWNER COPY (INITIAL): GOLD