IREDELL COUNTY HEALTH DEPARTMENT

Statesville Phone TR 3-7271 Mooresville Phone NO 3-1271

PERMIT TO INSTALL SEPTIC TANK

Permit NO. _____ Permit Date 13 March 1964.

Owner Hugh Johnson Address Winston Salem

Installed By Sam Stewart Address Trantham, N.C.


Location of Property _____

Tank		Capacity		Length of Lines		Fixtures	
Block	(X)	800	( )	150'	( )	No. of Baths	( )
Precast	( )	900	( )	175'	( )	Dishwasher	( )
		1000	(X)	200'	( )	Garbage Grdr.	( )
		1100	( )	225'	(X)	Auto-Washer	( )
		1200	( )	250'	( )	Other _____	
		Other _____		Other _____			

NOTIFY HEALTH DEPARTMENT AT LEAST EIGHT HOURS BEFORE TANK IS TO BE INSPECTED.

Final Inspection 13 March 1964 Approved (Y) Disapproved ( )

Remarks 560 sq ft – 3 Bdrm

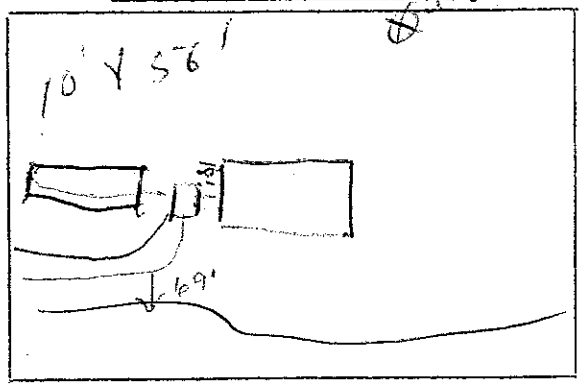

Sketch of Installation

Hugh Scoggin RS

Sanitarian