IREDELL COUNTY HEALTH DEPARTMENT

STATESVILLE 704-878-5305 MOORESVILLE 704-664-5281

IMPROVEMENT PERMIT / AUTHORIZATION TO CONSTRUCT / OPERATION PERMIT / EXISTING SYSTEM INSPECTION

PERMIT# 072509 PIN# 4638270199 DATE 3/30/98

OWNER OR CONTRACTOR John & Amy Steele (Amelia) PHONE: Business _____ Home _____

ADDRESS 3568 S. Wiptey Ford Rd Statesville, NC 28677

LOCATION 136 Adrian Ln - From Hall Rd TL 2nd Kenway Loop ~ 1/10 mile TR Adrian Ln ~ 200 yds on R

SUBDIVISION CLT BLOCK / SECTION 15 LOT _____ LOT AREA _____ SITE CLASS. Existing DESIGN FLOW _____ L.T.A.R. _____

Septic Tank: Existing Gallons; STB _____ Date _____
Pump Tank: _____ Gallons; PT _____ Date _____
Pump Make: _____ Model _____ Serial No. _____
Nitrification Field: No Fields _____ Square Feet _____ Linear Feet _____
No Lines Existing Trench Width Existing Max Trench Bottom Depth _____ Gravel Depth _____

☐ New System ☐ Repair System Type: I, II, III, IV, V, VI
System Description: Conv. - Conventional Bed
Repair System Description: _____
Maintenance Agreement Required: ☐ Yes ☐ No


☒ House/Mod. Home No. Bedrooms 3
☐ Mobile Home No. Bathrooms 2
☐ Business No. Employees _____
☐ Other _____
☐ Slab ☒ Crawl Space ☐ Basement w/plumbing ☐ Basement wo/plumbing

Water Supply:
☒ Individual
☐ Public
☐ Community

Comments:/Conditions: Septic System appeared to be functioning okay at time of inspection, No problems Noticed.

Comments:/Conditions: System originally installed for "Hugh Johnson in 1964" sized for 3 Bdrms Addition to Existing Structure / Upgrade.

INITIAL SITE SKETCH Not to Scale

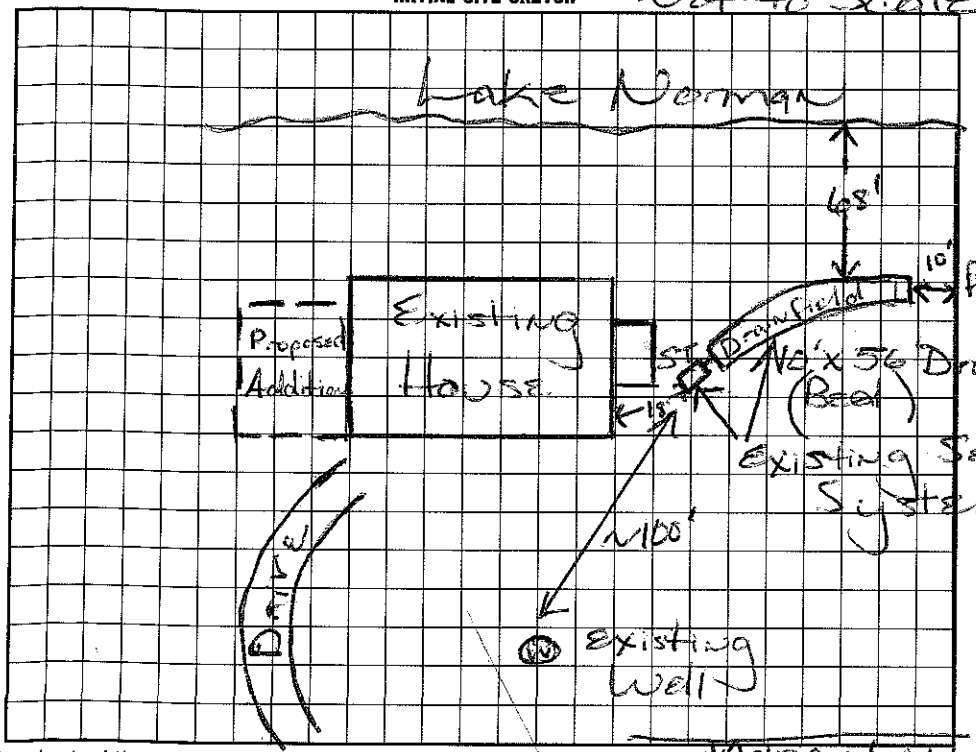

AS BUILT SKETCH

I understand that this permit can be suspended or revoked if any false information is supplied toward securing the permit/any unauthorized changes are made to the site/any unauthorized changes are made in the installation of the system. Improvement Permit with plat valid without expiration. Improvement Permit with site plan valid for sixty months. Authorization to Construct is valid for a period equal to that of Improvement Permit – not to exceed sixty months.

Signed: X Richard Fox date _____

Improvement Permit by: Marvin H. H. Dotson date 4/1/98

Authorization to Construct by: Marvin H. H. Dotson date 4/1/98

Installed by: _____

Operation Permit by: _____ date _____

Existing System Inspection by: _____ date _____

HEALTH DEPT. COPY: WHITE INSPECTION COPY (FINAL): GREEN OWNER COPY (FINAL): YELLOW INSPECTION COPY (INITIAL): PINK OWNER COPY (INITIAL): GOLD