IREDELL COUNTY HEALTH DEPARTMENT

Statesville Phone TR 3-7271 Mooresville Phone NO 3-1271

PERMIT TO INSTALL SEPTIC TANK

Permit No. _____ Permit Date May 1 1964

Owner Mr Tom Delk Address Mooresville N.C.

Installed By Stewart + Norwood Sanit Co. Address Troutman N.C.


Location of Property Lot 60 Lake Norman Sect 15

Tank		Capacity		Length of Lines		Fixtures	
Block	(X)	1000	(X)	225'	(X)	No. of Baths	( )
Precast	( )	1250	( )	250'	( )	Dishwasher	( )
		1500	( )	Other _____		Garbage Grdr.	( )
		Other _____				Other _____	

NOTIFY HEALTH DEPARTMENT AT LEAST EIGHT HOURS BEFORE TANK IS TO BE INSPECTED.

Final Inspection May 1 1964 Approved (X) Disapproved ( )

Remarks Last 16' Feet 12" deep

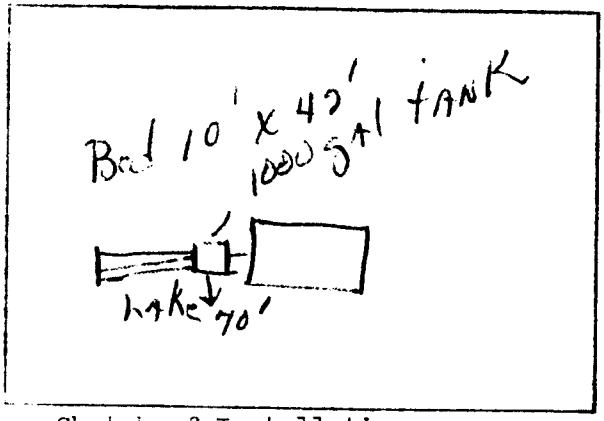

Sketch of Installation

Ray R. Leonard

Sanitarian