463827 3202

IREDELL COUNTY HEALTH DEPARTMENT

STATESVILLE 704-878-5305 MOORESVILLE 704-664-5281

IMPROVEMENT PERMIT / CERTIFICATE OF COMPLETION / OPERATION PERMIT / EXISTING SYSTEM INSPECTION

PROPERTY DESCRIPTION NO. Repair DATE 6/24/94 TAX MAP NO. REPAIR

OWNER OR CONTRACTOR Dr. Courtland Davis

ADDRESS Kenway Loop - Fern Hill TL 2ND Kenway Lp (R) 2nd gravel folk to end (ADRIANLANE TO END

PHONE: Business Home 910-723-7296 Watershed: ☐ Yes ☑ No

LOCATION

SUBDIVISION CHT BLOCK / SECTION 15 LOT LOT AREA SITE CLASS. DESIGN FLOW ~~360~~ 240 (360 ARS) L.T.A.R. .3

Septic Tank: 1000 EXISTING Gallons; STB 1012 Date 3/23/98

Pump Tank: 1000 Gallons; PT PT 17 Date 6/1/99

Pump Make: HYDROMATIC Model SK 50A1 Serial No. 2/98

Nitrification Field: No Fields 1 Square Feet 799 Linear Feet 266

No Lines 3(4) Trench Width 3' Max Trench Bottom Depth 36" Gravel Depth 12"

☐ New System ☑ Repair System Type: I (II) III, IV, V, VI

System Description: CONV -

Repair System Description:

Maintenance Agreement Required: ☐ Yes ☑ No

☑ House/Mod. Home ☐ Mobile Home ☐ Business ☐ Other

No. Bedrooms 2 No. Bathrooms 2 No. Employees


Water Supply: ☑ Individual ☐ Community ☐ Public

☐ Slab ☐ Crawl Space ☐ Basement w/plumbing ☐ Basement wo/plumbing

Comments: Pump Tank - Pump to conventional drainfield. Washer Box to A/B

Comments: 5-22-98 OK to use pressure manifold DRH

INITIAL SITE SKETCH

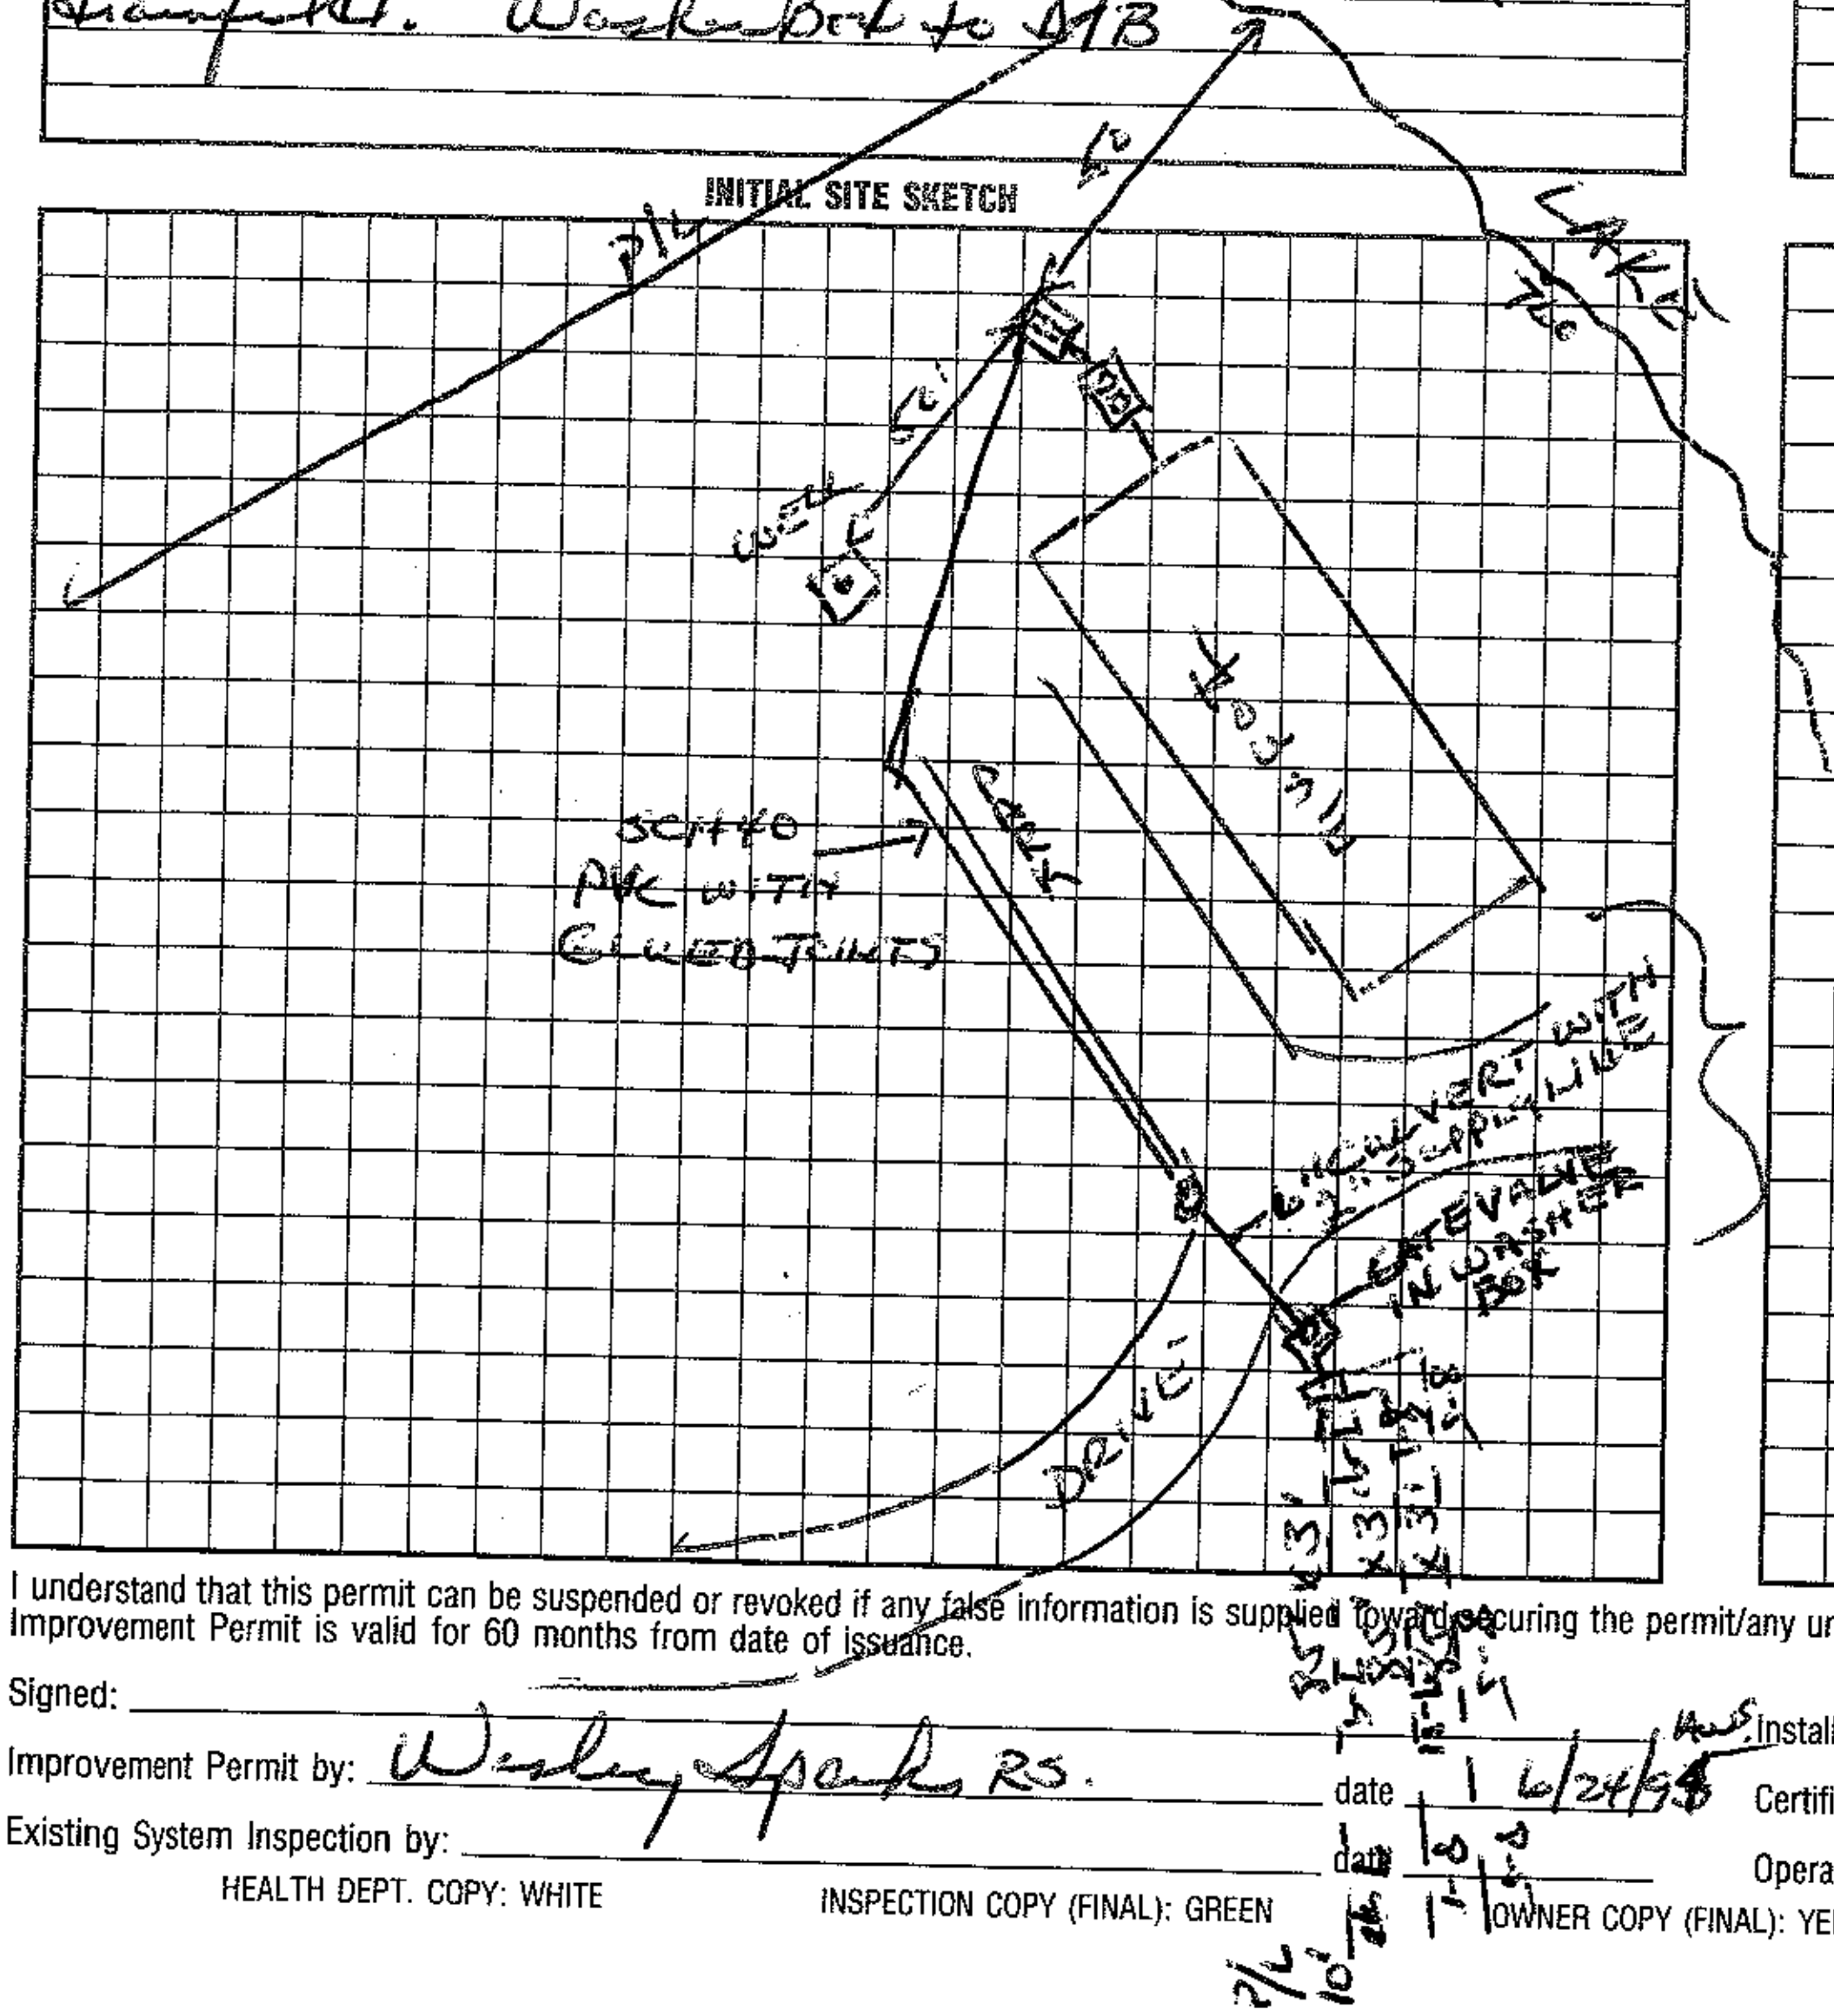

AS BUILT SKETCH

I understand that this permit can be suspended or revoked if any false information is supplied toward securing the permit/any unauthorized changes are made to the site/any unauthorized changes are made in the installation of the system. Improvement Permit is valid for 60 months from date of issuance.

Signed:

Improvement Permit by: Wesley Sparks RS. date 6/24/94

Existing System Inspection by: date

Installed by: Steve Jordan.

Certificate of Completion by: Wesley Sparks RS. date 6/8/98

Operation Permit by: Wesley Sparks RS. date 6/8/98

HEALTH DEPT. COPY: WHITE INSPECTION COPY (FINAL): GREEN OWNER COPY (FINAL): YELLOW INSPECTION COPY (INITIAL): PINK OWNER COPY (INITIAL): GOLD