owes $15.00

IREDELL COUNTY HEALTH DEPARTMENT

STATESVILLE 704-878-5305 MOORESVILLE 704-664-5281

IMPROVEMENT PERMIT / AUTHORIZATION TO CONSTRUCT / OPERATION PERMIT / EXISTING SYSTEM INSPECTION

PERMIT # 155586 217003 PIN # 4638289183.000 DATE 3/26/09

OWNER or APPLICANT Woodbridge Partners LLC/ Jonathan Smith PHONE: Business 704 799-9770 Home:

OWNER or APPLICANT ADDRESS PO Box 3608 Mooresville, NC 28117

LOCATION / DIRECTIONS Perth Rd (N) TL Fern Hill Rd. TL Kenway Ln on (R)

SUBDIVISION Fernleaf BLOCK / SECTION -1- LOT # 13 LOT AREA .723 DESIGN FLOW 480 L.T.A.R. .275

Septic Tank 1000 Gallons: STB 794 Date 4-25-16
Pump Tank 1000 Gallons: PT 27 Date 4-27-16
Pump Make Myers Model ME45521 Serial #
Nitrification Field No Fields 1 No Lines 6 Linear Feet 437'
Trench Width 36" Max. Trench Bottom Depth 36" Gravel Depth N/A

☑ New System ☐ Repair ☐ Expansion System Type: I II III IV V VI
System Description: Pump 25% Reduction
Repair System Description: LP-PPBPS
Maintenance Agreement Required ☐ YES ☑ NO
☐ GRAVITY ☑ PRESSURE

☑ Residence No. Bedrooms 4
☐ Business No. Persons
☐ Other No. Employees
☐ Slab ☑ Crawl Space
☐ Basement w/plumbing ☐ Basement w/o plumbing

Water Supply: ☑ Private ☐ Public ☐ Community

Comments / Conditions: Lot requires slight shaping to remove old berms/field terraces.

Comments / Conditions: 2/29/16 Reviewed floor plans, in Compliance with Septic plan

INITIAL SITE SKETCH

See Plans by S&ME

AS BUILT SKETCH

INSTALLED GC74
6-2-16 CHECKED TANKS, LINES

7/27/16 2" Pressure head ok, Electrical box ok
3" feather + 12" distance between on/off
Float and alarm Float. Breakers ok.

Permit can be suspended or revoked if any false information is supplied toward securing the permit / any unauthorized changes are made to the site / any unauthorized changes are made in the installation of the system.

☑ IMPROVEMENT PERMIT w/ plat valid without expiration. ☒ IMPROVEMENT PERMIT w / site plan valid for 60 mos. ☒ AUTHORIZATION TO CONSTRUCT valid for period equal to IMPROVEMENT PERMIT-not to exceed 60 mo.

Owner / Applicant Signature: Kathleen Saunders Date 3/27/09

Improvement Permit by: Anthony Coker Jr. R.S. Date 3/26/09

Authorization to Construct by: [signature] R.S. Date 2/29/16


YOU SHOULD CONTACT A LOCATOR SERVICE PRIOR TO ANY EXCAVATION.

Installed by: R&H

Operation Permit by: [signature] Date: 7-27-16

Existing System Inspected by: Date:

WHITE COPY Environmental Health YELLOW COPY (Final) Owner / Applicant PINK COPY (Initial) Owner / Applicant

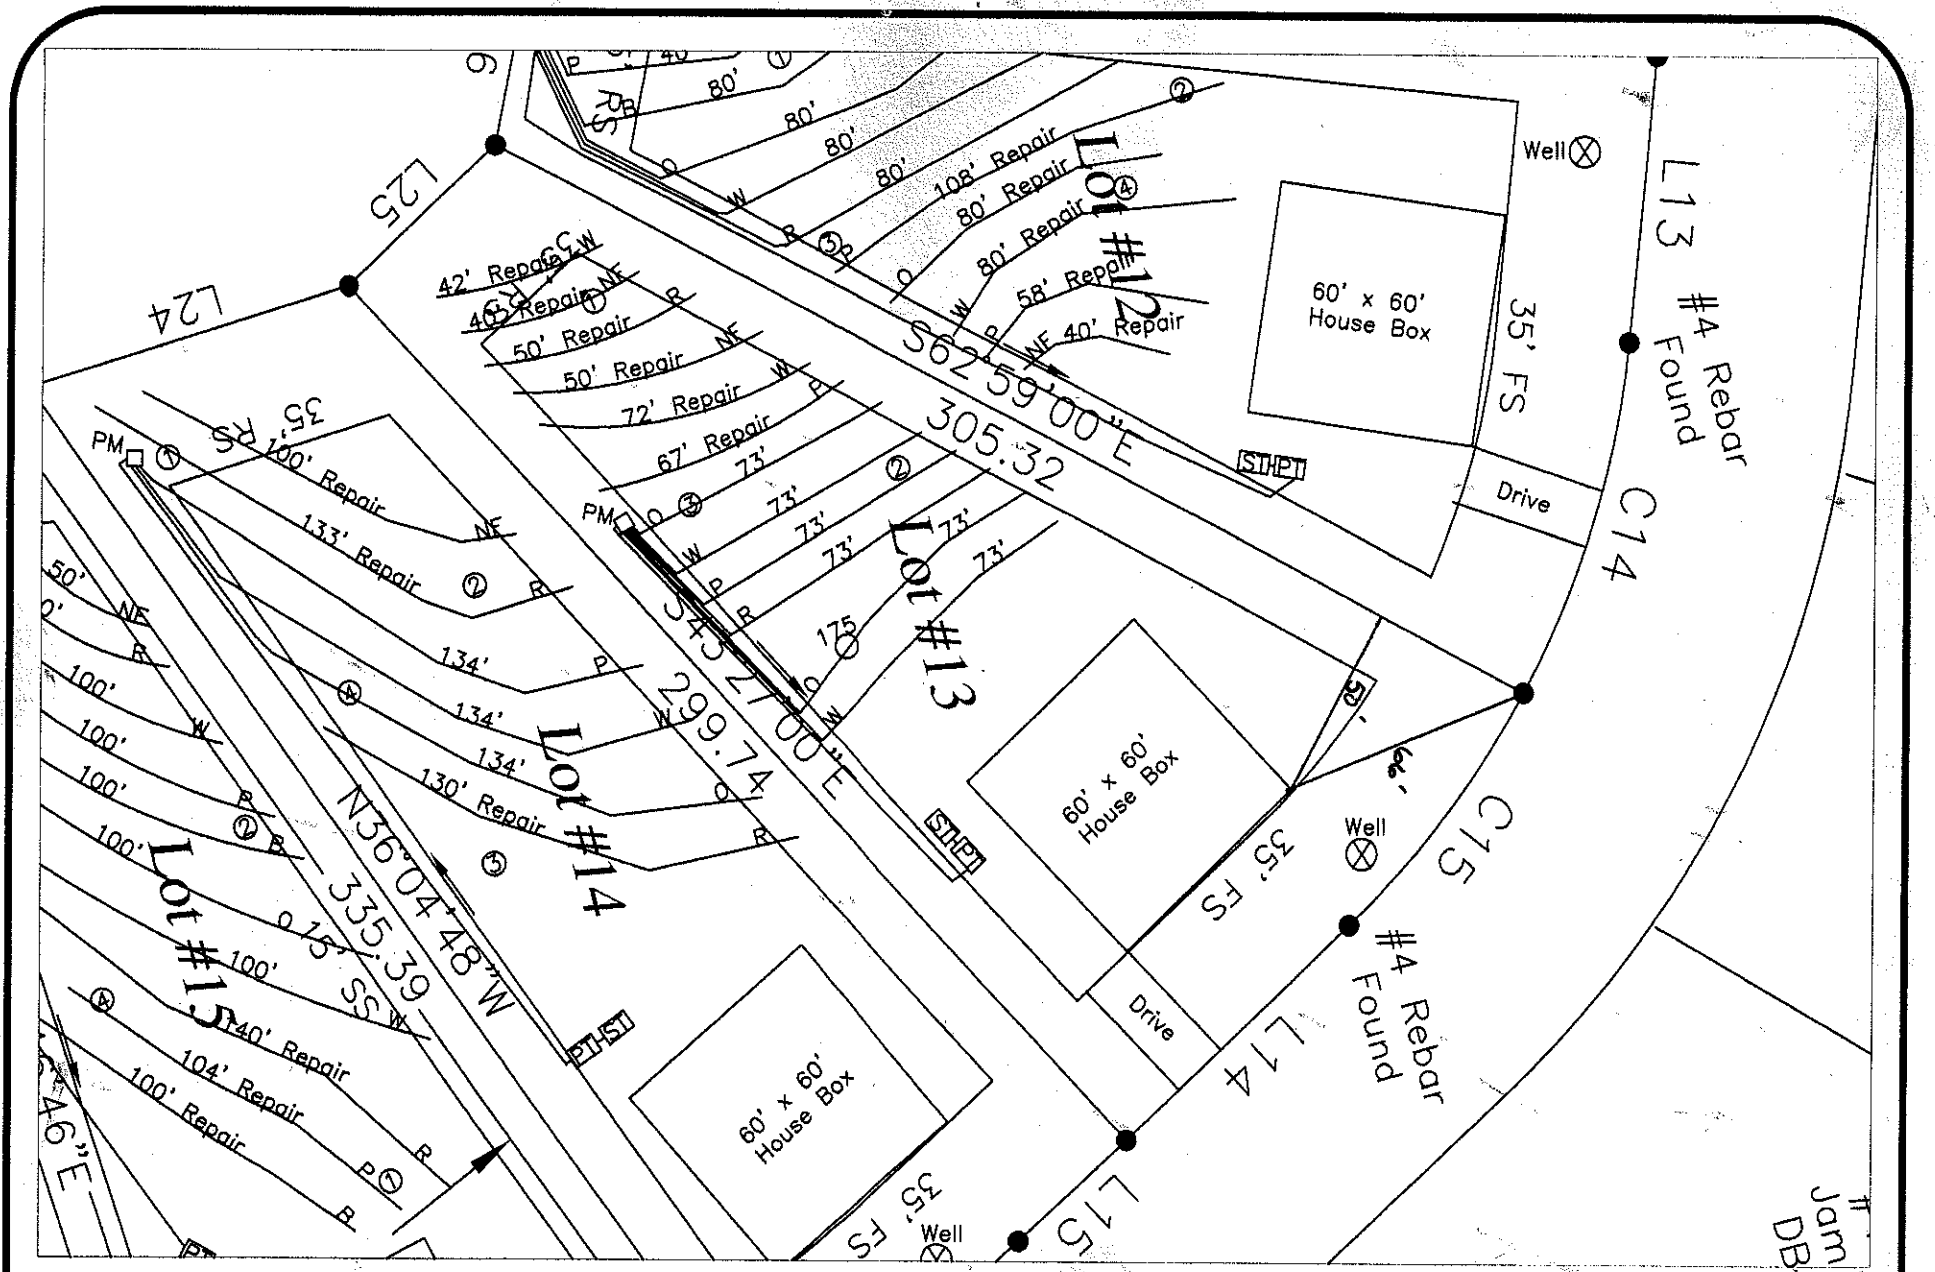

SCALE: 1" = 50'	DATE: March, 2009	S&ME 3718 OLD BATTLEGROUND ROAD GREENSBORO, NC 27410 PH: 336-288-7180 FAX: 336-288-8980 WWW.SMEINC.COM	Lot 13 Fern Leaf Subdivision – Kenway Loop. Iredell County, NC
PROJECT NO. 1588-09-012	DRAWN BY: KMS		FIGURE NO. 1
	CHECKED BY: PGP		