ICHD - ENVIRONMENTAL HEALTH DIVISION

Statesville Office (704) 878-5305 | Mooresville Office (704) 660-3625 (Relocation) | PERMIT # AP 318417

SEPTIC: IMPROVEMENT PERMIT / AUTHORIZATION TO CONSTRUCT / OPERATION PERMIT / EXISTING SYSTEM

PIN # 4638--28--9183

APPLICANT/OWNER: Alexander Soto | APPLICANT ADDRESS: 596 Kenway Lp. Mooresville, NC 28117

SITE ADDRESS: 596 Kenway Lp Mooresville, NC 28117 | PHONE: 614 975-8630 | ALT. PHONE

SITE DIRECTIONS: Perth Rd N TL Fernhill TL (2nd) Kenway Lp on left | SAP CONTROLLED: ☐ YES ☒ NO

SUBDIVISION: Fernleaf | SECTION: 1 | LOT # 13 | LOT AREA: 1.723 Ac. | DESIGN FLOW: 480 gpd | L.T.A.R.: .3

Septic Tank	Exist (gal)	STB	Date	☒ New System	☐ Repair	☐ Expansion	System Type: I II III IV V VI	☒ Residence	No. Bedrooms 4
Pump Tank	Exist (gal)	PT	Date	System Description: Relocate Pump-PM-25% Reduction				☐ Business	No. Persons 8
Pump Make	Model		Serial #	Repair System Description: LPPPBPS				☐ Other	No. Employees
# Nitrification Fields 1	# Lines 2@54' ea		Linear Ft 108'	Maintenance Agreement Required:	☐ YES	☒ NO		☐ Slab	☒ Crawl Space
Trench Width 36"	Trench Bottom Depth (Low side) max		35"	Gravel Depth N/A	☐ GRAVITY	☒ PRESSURE		☐ Basement w/ plumbing	☐ Basement w/o plumbing


Water Supply: ☒ Private ☐ Public ☐ Community

Comments / Conditions: Must abandon Septic System within 15ft of pool "cut". Relocate Pressure Manifold (PM) to highest drainline. Install drainlines above Current drainfield. 2 lines @ 54ft ea.

The purpose of this permit is to relocate existing drainfield that will be within 15ft setback to swimming pool. PM details ~~Use~~ Use 1½" sch 80 taps for 5 ft lines. Use 1½" sch 40 for Existing lines.


INITIAL SITE SKETCH

Scale 1:50

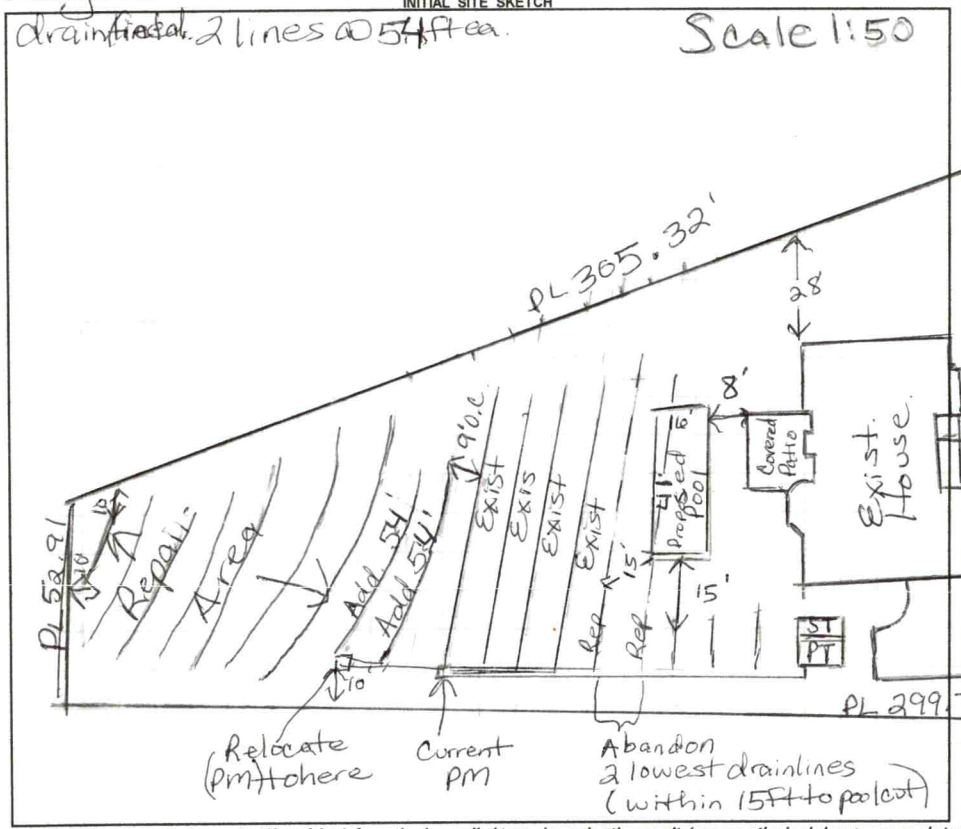

AS BUILT SKETCH

FOR SEPTIC FINAL INSPECTION CALL: 704-664-3703 between 8am-9am the day the inspection is needed. Be sure to speak with an inspector to confirm your time.

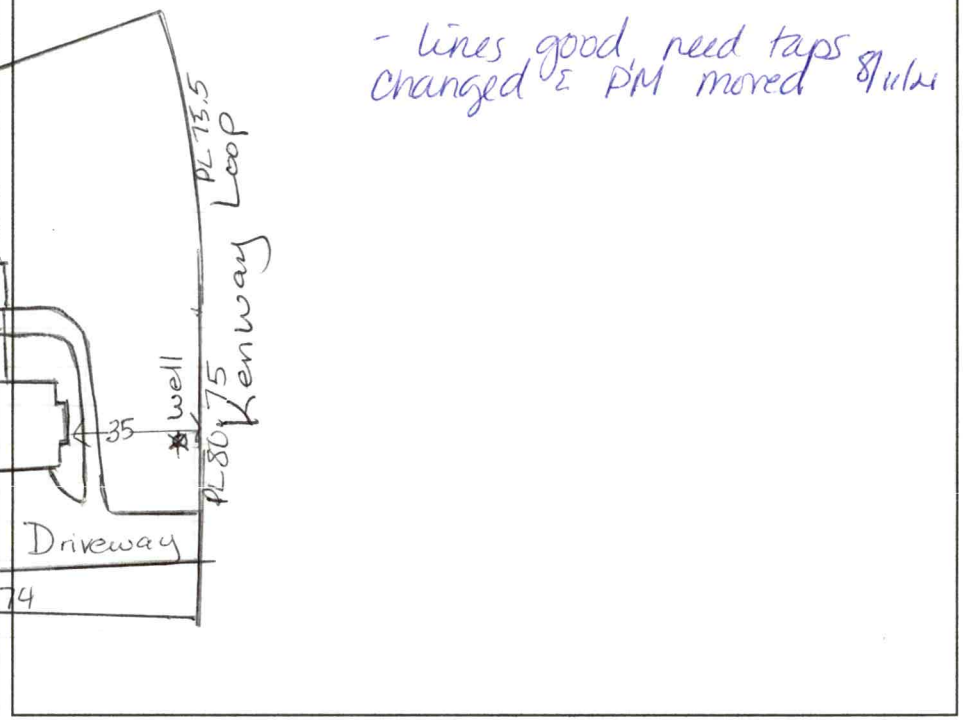

- lines good, need taps changed & PM moved 8/11/21

Permit can be suspended or revoked if any false information is supplied toward securing the permit / any unauthorized changes are made to the site / any unauthorized changes are made in the installation of the system. **CONTACT A LOCATOR SERVICE PRIOR TO ANY EXCAVATION**

☐ **IMPROVEMENT PERMIT** *with plat valid without expiration.* ☒ **IMPROVEMENT PERMIT** *with site plan valid for 60 mos.* ☒ **AUTHORIZATION TO CONSTRUCT** *valid for period equal to IMPROVEMENT PERMIT--not to exceed 60 mo.*

Owner / Applicant Signature: _____ Date: _____ Installed by: Alan Hoke

IMPROVEMENT PERMIT by: Maia Nelson Date: 7/2/21 OPERATION PERMIT by: D. Inteberg Date: 8/12/21

AUTHORIZATION TO CONSTRUCT by: Maia Nelson Date: 7/2/21 Existing System Inspected by: _____ Date: _____

FOR SEPTIC FINAL INSPECTION: CALL 704-664-3703 between 8am-9am the day the inspection is needed.

DEPARTMENT OF HEALTH AND HUMAN SERVICES
DIVISION OF PUBLIC HEALTH, ENVIRONMENTAL HEALTH SECTION
ON-SITE WATER PROTECTION BRANCH

Sheet ___ of
PROPERTY ID #: 463889183
COUNTY: Fredell

SOIL/SITE EVALUATION
for **ON-SITE WASTEWATER SYSTEM**
(Complete all fields in full)

OWNER: Alexander Soto
ADDRESS: 5946 Kenwood Dr. Mtville, NC
PROPOSED FACILITY: House
LOCATION OF SITE: Fernleaf #13
APPLICATION DATE
DATE EVALUATED: 6/25/21
PROPOSED DESIGN FLOW (.1949): 480gpd
PROPERTY SIZE:
PROPERTY RECORDED:

WATER SUPPLY: ☒ Private ☐ Public ☐ Well ☐ Spring ☐ Other
EVALUATION METHOD: ☐ Auger Boring ☒ Pit ☐ Cut
TYPE OF WASTEWATER: ☒ Sewage ☐ Industrial Process ☐ Mixed

PROFILE #	.1940 LANDSCAPE POSITION/ SLOPE %	HORIZON DEPTH (IN.)	SOIL MORPHOLOGY (.1941) .1941 STRUCTURE/ TEXTURE	SOIL MORPHOLOGY (.1941) .1941 CONSISTENCE/ MINERALOGY	OTHER PROFILE FACTORS .1942 SOIL WETNESS/ COLOR	.1943 SOIL DEPTH	.1956 SAPRO CLASS	.1944 RESTR HORIZ	PROFILE CLASS & LTAR
1	8%	0-10	Brn SCL w SBK SS, SP, SEXP, FR						PS .3
		10-30	RC mw SBK SS, SP, SEXP, FR						
		30-50	RC mw SBK SS, SP, SEXP few SAP, Inclus						
2	8%	0-7	Brn SCL w SBK SS, SP, SEXP, FR						PS .3
		7-31	RC mw SBK SS, SP, SEXP, FR						
		31-50	RC w SBK SS, SP, SEXP, FR wp few SAP	Inclus					
3									
4									

DESCRIPTION	INITIAL SYSTEM	REPAIR SYSTEM
Available Space (.1945)	PS	PS
System Type(s)	25% Red	PRB PS
Site LTAR	.3	.3

OTHER FACTORS (.1946):
SITE CLASSIFICATION (.1948):
EVALUATED BY: Maria Dotson
OTHER(S) PRESENT: Josh Hunsucker


THIS SITE PLAN IS TO SHOW THE PROPOSED LOCATION OF THE HOUSE ON THE LOT AND IS NOT TO BE RELIED UPON FOR CONSTRUCTION.

NOTE: DELTA LAND SERVICES IS NOT RESPONSIBLE FOR ANY CHANGES DUE TO UNRECORDED COVENANTS AND RESTRICTIONS

DELTA LAND SERVICES, INC.
FIRM LICENSE #C-735
608-G Matthews Mint Hill Road
MATTHEWS, NORTH CAROLINA 28105
(704) 847-4700

MB 56 PG 20

SCALE: 1"=50'

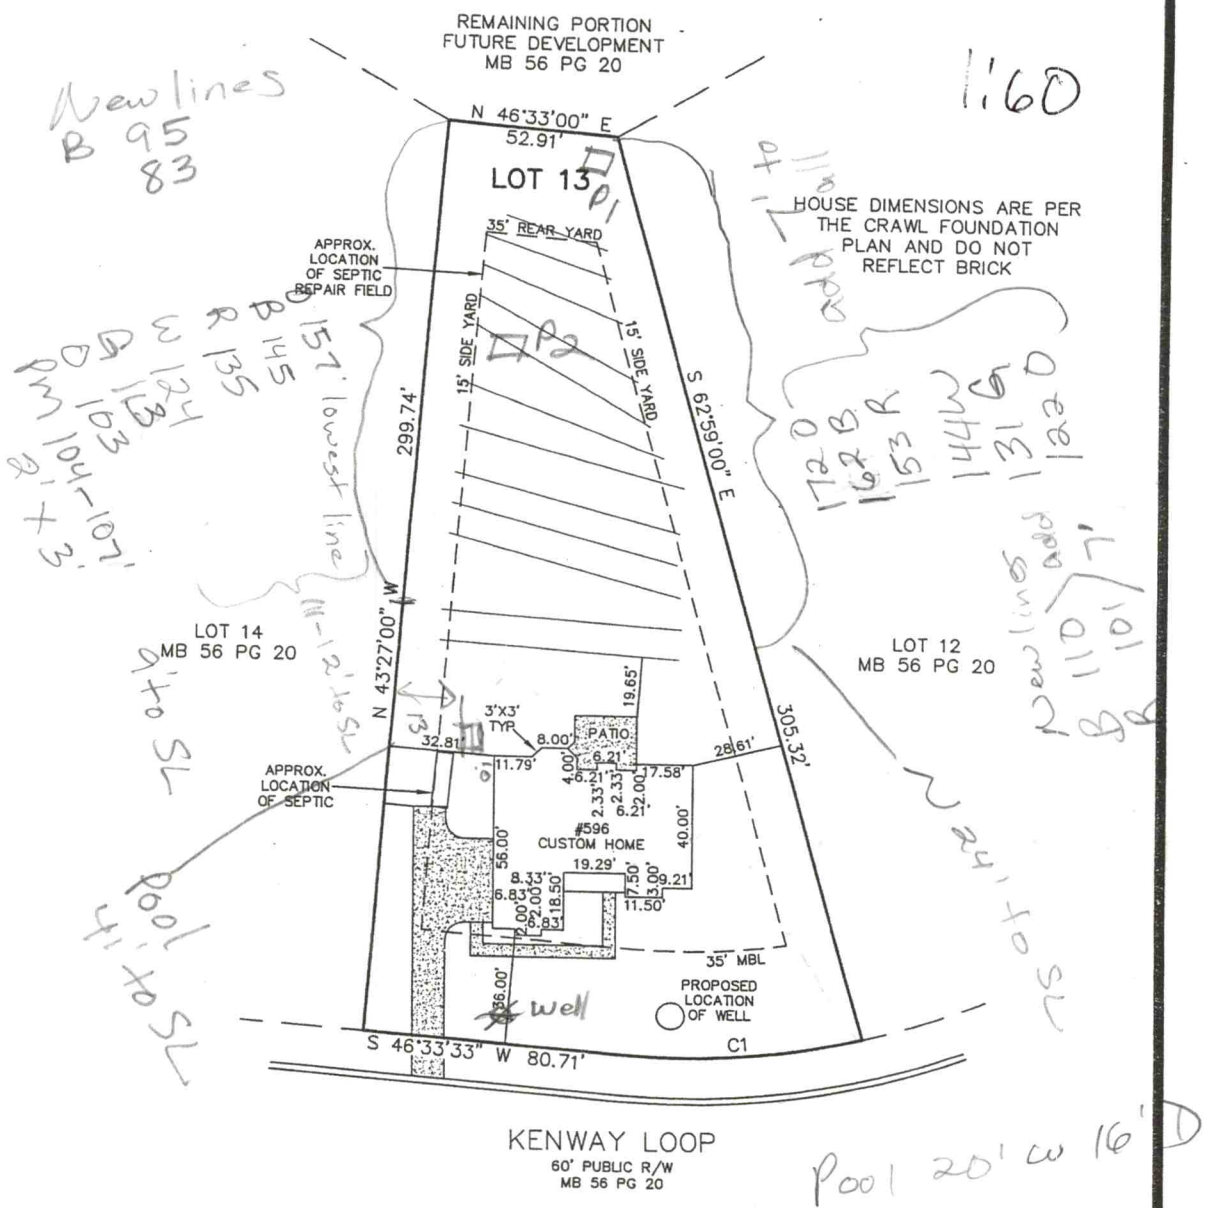

CURVE TABLE					
CURVE	RADIUS	LENGTH	CHORD	BEARING	DELTA
C1	235.66'	75.57'	75.25'	N37°22'20"E	18°22'27"

NOT FOR RECORDATION, CONVEYANCES OR SALES

STAKEOUT ☐

Subdivision FERNLEAF SUBDIVISION PHASE 1 County IREDELL
Lot 13 Block ___ Plan CUSTOM Elevation ___ Drive (Left) SIDE (Right) ___ (Courtyard) ___ Deck ___
Patio X Fireplace REAR Garage (1 Car) ___ (2 Car) ___ (3 Car) X Brick ___ Basement ___ Curtain Wall ___
Crawl ___ X Slab ___ Other ___

REVISED:

DWN: JDA CKD: [illegible] DATE: 02/02/16

fernleaf\FERN-0013.dwg

RECEIVED JUN C 2 2021 Friday AM

APPLICATION MUST BE FILLED OUT COMPLETELY & BE LEGIBLE OR IT WILL NOT BE PROCESSED

Iredell County Health Department – Environmental Health Division

Relocation

PAGE 1: *APPLICATION FORM* AP-318417 $500.00

Application For: ( ) New Well Permit ( ) Well Repair Permit ( ) Well Abandonment
(X) Septic Improvement Permit ( ) Authorization to Construct ( ) Existing System Inspection ( ) Septic System Repair

THE ABOVE PERMIT DOCUMENTS WILL BECOME INVALID IF INFORMATION PROVIDED ON THIS APPLICATION IS FALSIFIED OR CHANGED, OR IF THE SITE IS ALTERED. THE IMPROVEMENT PERMIT IS VALID FOR EITHER 60 MONTHS OR WITHOUT EXPIRATION DEPENDING UPON DOCUMENTATION SUBMITTED. APPLICATION WITH SITE PLAN 60 MONTHS, APPLICATION WITH COMPLETE, SCALED PLAT WITHOUT EXPIRATION. SEE 15A NCAC 18A .1937(f) FOR DETAILS.

Page 2: *Site Plan Worksheet* form MUST accompany this application

The following optional attachments may also be submitted: ( ) Survey Plat, scaled no more than 1 inch = 60 feet
Place an (X) *beside whichever is submitted if applicable* ( ) Custom Site Plan, scaled no more than 1 inch = 60 feet

Applicant Information: (PRINT CLEARLY)

Applicant Name: ALEXANDER SOTO Address: 596 KENWAY LOOP Zip: 28117
Applicant Email: alex.soto7@gmail.com Phone: 614-975-8130 Alt. Phone:
Owner Name: ALEXANDER SOTO Address: 596 KENWAY LOOP Zip: 28117
Owner Email: alex.soto7@gmail.com Phone: 614-975-8130 Alt. Phone:

Property Information:

Street Address: 596 KENWAY LOOP
Subdivision Name: FERN LEAF Section/Phase: 1 Lot Number: 13
Driving Directions: Perth to Fern Hill to Kenway Loop.

Site Development Information: *(check or complete ALL that apply*

( ) New Single Family Residence
( ) New Multi-Family Residence
( ) Accessory Building
( ) Bedroom(s) Addition
( ) Repair to failing septic system ___ Tank ___ Drain lines Describe Problem:
Maximum Number of Bedrooms: 4
Maximum Number of Occupants: 4
Swimming Pool
( ) Other Addition/Structure:
Non-Residential Site Development: Type of Business:
Square Footage of Building: Max. Number of Employees: Max. Number of Seats/Beds/Other:

CHECK FOUNDATION TYPE
(✓) Crawl Space Foundation
( ) Concrete Slab Foundation
( ) Basement with Plumbing
( ) Basement without Plumbing

Water Supply: ( ) Replacement Well – Reason:
( ) Multi-connection Well Number of Houses: Number of Persons:
( ) New Well (✓) Existing Well ( ) Community Well ( ) City Water ( ) Other Public Water

Desired Septic System Type: *(you may rank in order of preference)* Year existing system installed:
( ) No Preference ( ) Alternative ( ) Conventional ( ) Innovative ( ) Modified Conventional ( ) Other:

Please answer the following to the best of your ability:
( ) Yes (X) No Does the site contain any jurisdictional wetlands?
( ) Yes (X) No Is any non-domestic sewage (i.e. industrial) to be generated?
( ) Yes (X) No Is the site subject to approval by any other public agency?

I have read this application and certify that the information provided herein is true, complete, and correct. Authorized county and state officials are granted right of entry to conduct necessary inspections to determine compliance with applicable laws and rules. I understand that I am solely responsible for the proper identification and labeling of all property lines and corners and making the site accessible so that a complete site evaluation can be performed.

Signature: _____ 6/2/21
Property owner or owner's legal representative signature (SIGNATURE REQUIRED) DATE

IREDELL COUNTY DEPARTMENT OF ENVIRONMENTAL HEALTH

DOCUMENTATION TO AUTHORIZE AN OWNER'S LEGAL REPRESENTATIVE

(Check and sign only ONE of the options below)

☒ **1. * APPLICANT AND OWNER ARE THE SAME. *** (*Sign here*) _____

Applications for permits require the "signature of the owner or owner's legal representative" (15A NCAC 18A .1937). If the owner does not sign the application himself or herself, they can submit any one of the following documents to designate their legal representative: *Power of Attorney; Real Estate Contract; Estate executor; Bankruptcy trustee; Court ordered guardianship*
In the absence of the above documentation, the property owner may provide the local health department with documentation that designates a legal representative. A property owner may:
Complete this form to document his or her legal representative, or provide his or her own form that contains the information in this form. If there are multiple property owners, then all property owners must sign the form that designates a legal representative.
By signing a form that designates a legal representative for purposes of 15A NCAC 18A .1937, the property owner authorizes that representative to act on their behalf in matters pertaining to the application and permitting process, including signing or receiving any application, document or permit. The owner retains full responsibility to meet all permit conditions specified by the local health department.

☐ **2.** I, _____, am the legal owner(s) of the property located at _____, identified as PIN (Parcel Identification Number)_____, located in Iredell County, North Carolina.

I do hereby authorize (**print legal representative/company name**) _____, _____, to act as an agent on my behalf in applying for/signing/obtaining any of the documents described below.

- Application for Improvement Permit (IP) / Authorization to Construct (AC)
- Improvement Permit (IP) / Authorization to Construct (AC)
- Application for soil-site evaluation (new/repair)
- Application/permit for private drinking water well/well abandonment
- Application for Compliance Inspection

I agree to abide by all decisions and/or conditions between the legal representative acting on my behalf and the Iredell County Department of Public Health, Environmental Health Division.

_____ _____
Signature of Owner(s) Date

Mooresville - Environmental Health
Fax: 704-662-3239
610 E. Center Avenue, Mooresville, NC 28115

Statesville - Environmental Health
ronda.hart@co.iredell.nc.us
Fax: 704-871-3483
349 N. Center Street, Statesville, NC 28677