4.5

IREDELL COUNTY HEALTH DEPARTMENT

Statesville Office (704) 878-5305 Mooresville Office (704) 660-3625 PERMIT # 213653

IMPROVEMENT PERMIT / AUTHORIZATION TO CONSTRUCT / OPERATION PERMIT / EXISTING SYSTEM

PIN # 4638-28-9368.000

APPLICANT: Carolyn T. Spicas (Pool By Design) APPLICANT ADDRESS: 217 Foxwood Ave. Charlotte NC 28211

SITE ADDRESS: 580 Kenway LP. Mooresville NC PHONE: 704-333-7446 ALT. PHONE: 704-634-2055 704-622-2909

SITE DIRECTIONS: Rte 3 to Fern Hill, R Kenway LP., Site on R

SUBDIVISION: Fernleaf SECTION: LOT # 11 LOT AREA: .849 acre DESIGN FLOW: Ex. 480 GPD T.A.R.: Existing

Septic Tank Existing (gal) STB Date
Pump Tank (gal) PT Date
Pump Make Model Serial #
Nitrification Fields Ex # Lines Ex Linear Ft: Ex.
Trench Width Ex Max. Trench Bottom Depth Ex Gravel Depth N/A

☐ New System ☐ Repair ☐ Expansion System Type: I II III IV V VI
System Description: Existing 75% Reduction - Gravity
Repair System Description: LP - PTDS
Maintenance Agreement Required: ☐ YES ☒ NO
☒ GRAVITY ☐ PRESSURE


☒ Residence No. Bedrooms Ex 4
☐ Business No. Persons Ex 8
☐ Other No. Employees
☐ Slab ☒ Crawl Space
☐ Basement w/plumbing ☐ Basement w/o plumbing

Water Supply: ☒ Private ☐ Public ☐ Community

Comments / Conditions: System Approved to be Functioning @ Time of Inspection. This Permit for Proposed Pool.

INITIAL SITE SKETCH

AS BUILT SKETCH

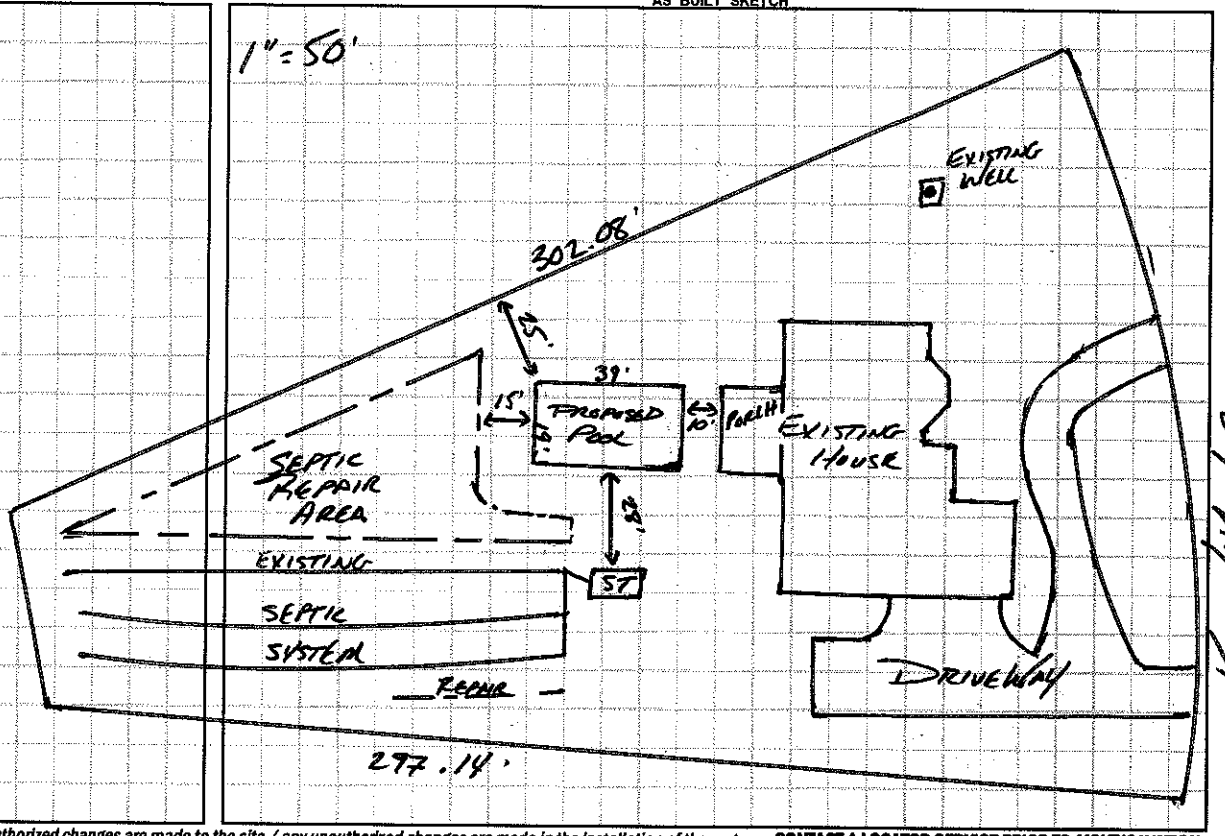

Permit can be suspended or revoked if any false information is supplied toward securing the permit / any unauthorized changes are made to the site / any unauthorized changes are made in the installation of the system. **CONTACT A LOCATOR SERVICE PRIOR TO ANY EXCAVATION**

☐ **IMPROVEMENT PERMIT** *with plat valid without expiration.* ☐ **IMPROVEMENT PERMIT** *with site plan valid for 60 mos.* ☐ **AUTHORIZATION TO CONSTRUCT** *valid for period equal to IMPROVEMENT PERMIT--not to exceed 60 mo.*

Owner / Applicant Signature: Carolyn T Spicas Date: 10/30/15 Installed by:

IMPROVEMENT PERMIT by: Date: OPERATION PERMIT by: Date:

AUTHORIZATION TO CONSTRUCT by: Date: Existing System Inspected by: Date: 10/27/15

Health Dept. Copy - WHITE Applicant (Final Approval) - YELLOW Applicant (Conditional Approval) - PINK