IREDELL COUNTY HEALTH DEPARTMENT *ENVIRONMENTAL HEALTH DIVISION*:

SITE PLAN WORKSHEET

SEE THE "SAMPLE SITE PLAN" BELOW. ***INCOMPLETE SITE PLANS WILL BE RETURNED TO YOU FOR COMPLETION AND MAY RESULT IN A DELAY IN THE ISSUANCE OF YOUR SEPTIC SYSTEM PERMIT!!!***

Place an (X) beside each item as you complete the site plan:

X Property Line measurements are clearly identified... **X All proposed structures are indicated...**

SHOW: proposed house or business footprint, wells, water lines, patios, pools and decks, and any other item that will occupy space on the site

____ Front and side setbacks from property line... **____ Preferred driveway location and configuration, preferred well location...**


____ Area you prefer your septic system to be placed... **____ North arrow, or other sufficient indicator of direction...**

Circle N/A on the following if appropriate:

____ Location of septic systems and wells within 100' of your property... N/A

____ Location of easements and rights of ways on your property... N/A **____ Location of any designated wetlands on the property... N/A**

* See Attached

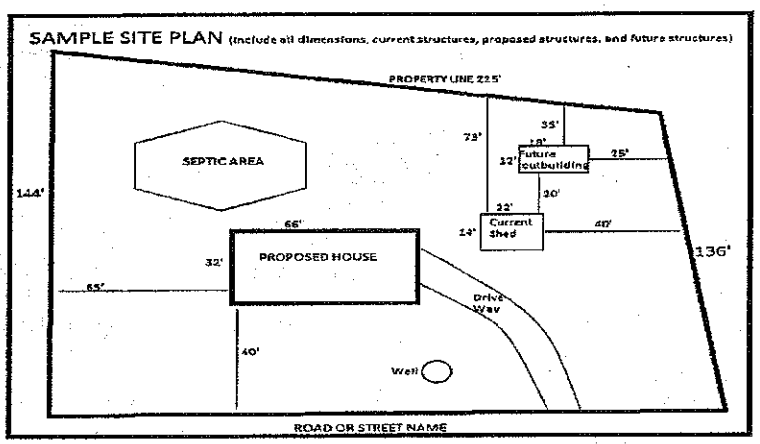

USE THIS SPACE TO DRAW YOUR SITE PLAN

See Attached

Signature: _____
REQUIRED property owner or owner's legal representative signature.

9/18/15
DATE

owes Ø

IREDELL COUNTY HEALTH DEPARTMENT

STATESVILLE 704-878-5305 MOORESVILLE 704-664-5281

IMPROVEMENT PERMIT / AUTHORIZATION TO CONSTRUCT / OPERATION PERMIT / EXISTING SYSTEM INSPECTION

PERMIT # 155584 PIN # 4638289368.000 DATE 3/23/09

OWNER or APPLICANT Woodbridge Partners LLC Heritage Pkl PHONE: Business 704 799-9770 Home:

OWNER or APPLICANT ADDRESS PO Box 3608 Mooresville NC 28117

LOCATION / DIRECTIONS Perth Rd (N) TL Fern Hill Rd TL Kenway Lp on (R)

SUBDIVISION Fernleaf BLOCK / SECTION LOT # 11 LOT AREA .849 DESIGN FLOW 480 gpd L.T.A.R. .3

Septic Tank 1000 Gallons: STB 1007 Date 2-15-09
Pump Tank Gallons: P.T. Date
Pump Make Model Serial #
Nitrification Field No Fields 1 No Lines 3 Linear Feet 402'
Trench Width 36" Max. Trench Bottom Depth 36" Gravel Depth N/A

☑ New System ☐ Repair ☐ Expansion System Type I (II) III IV V VI
System Description: Gravity 25% Reduction
Repair System Description: ILPPPBPS
Maintenance Agreement Required ☐ YES ☑ NO
☑ GRAVITY ☐ PRESSURE


☑ Residence No. Bedrooms 4
☐ Business No. Persons
☐ Other No. Employees
☐ Slab ☑ Crawl Space
☐ Basement w/plumbing ☐ Basement w/o plumbing

Water Supply: ☑ Private ☐ Public ☐ Community


Comments / Conditions: Lot requires some shaping to remove old Field terraces, Knock down high spots do not fill Drainfield area.

Comments / Conditions: 10/12/09 Reviewed Floor plans. in compliance with Original permit

INITIAL SITE SKETCH

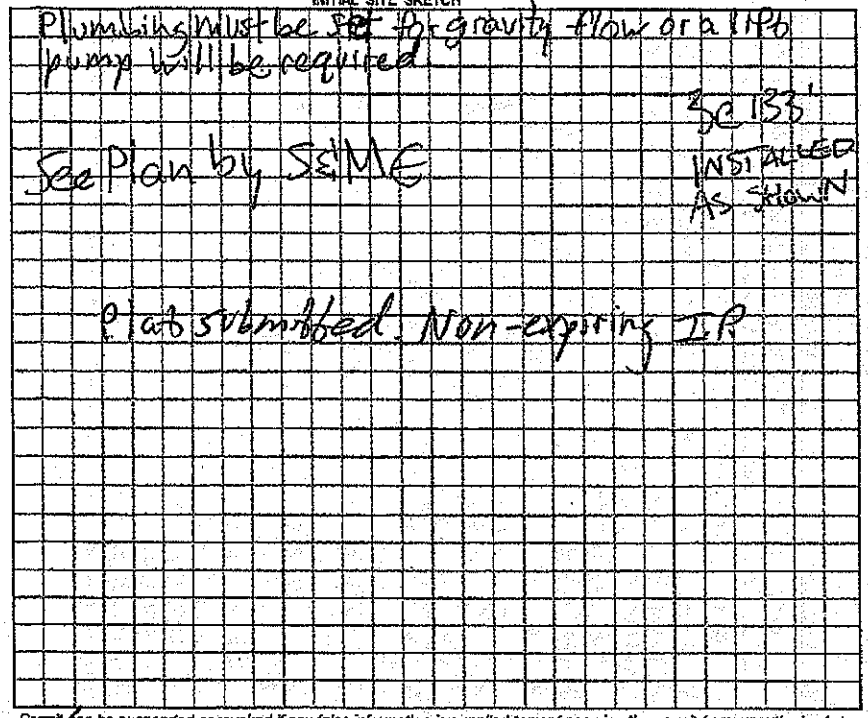

AS BUILT SKETCH

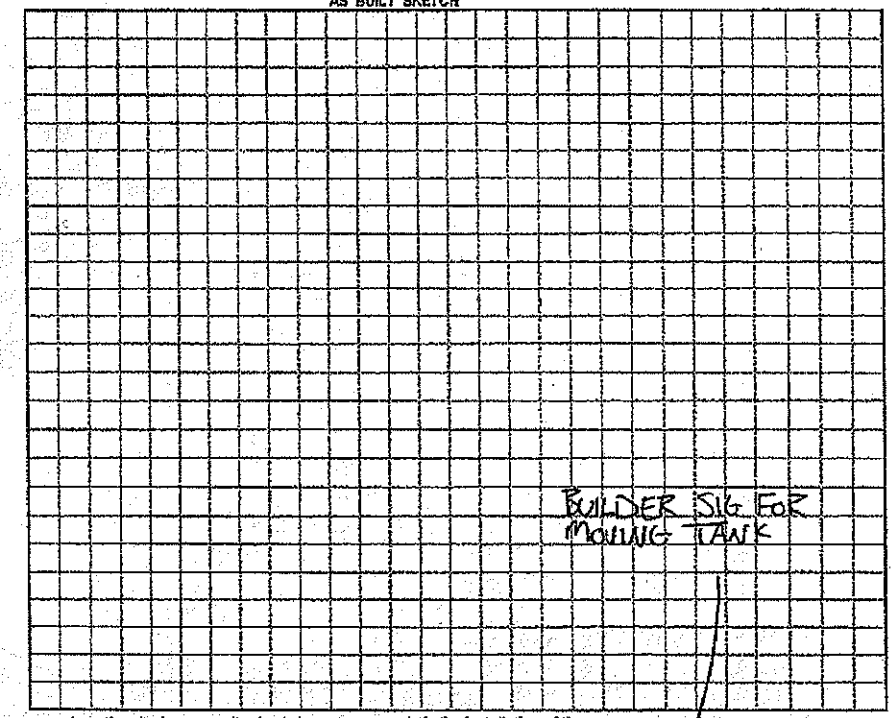

Permit can be suspended or revoked if any false information is supplied toward securing the permit / any unauthorized changes are made to the site / any unauthorized changes are made in the installation of the system.

☑ IMPROVEMENT PERMIT w/ plat valid without expiration. ☑ IMPROVEMENT PERMIT w/ site plan valid for 60 mos. ☐ AUTHORIZATION TO CONSTRUCT valid for period equal to IMPROVEMENT PERMIT-not to exceed 60 mo.

Owner / Applicant Signature: Kathleen Saunders Date 3/27/09

Improvement Permit by: Anthony Cokeley, R.S. Date 3/23/09

Authorization to Construct by: Maina Kelly Olson, R.S. Date 10/12/09

YOU SHOULD CONTACT A LOCATOR SERVICE PRIOR TO ANY EXCAVATION.

Installed by: WAYNE CONTZ


Operation Permit by: [signature] REHS Date: 4-7-10

Existing System Inspected by: [signature] Date: 4-9-10

WHITE COPY Environmental Health YELLOW COPY (Final) Owner / Applicant PINK COPY (Initial) Owner / Applicant

SEP-1-2009 03:45P FROM:STALLINGS REFRIGERAT 7045968519 TO:17045463397 P.3

Acknowledgement Of
Plans Submittal ONLY!
City Manager Date 10/12/09
Date 10-12-09

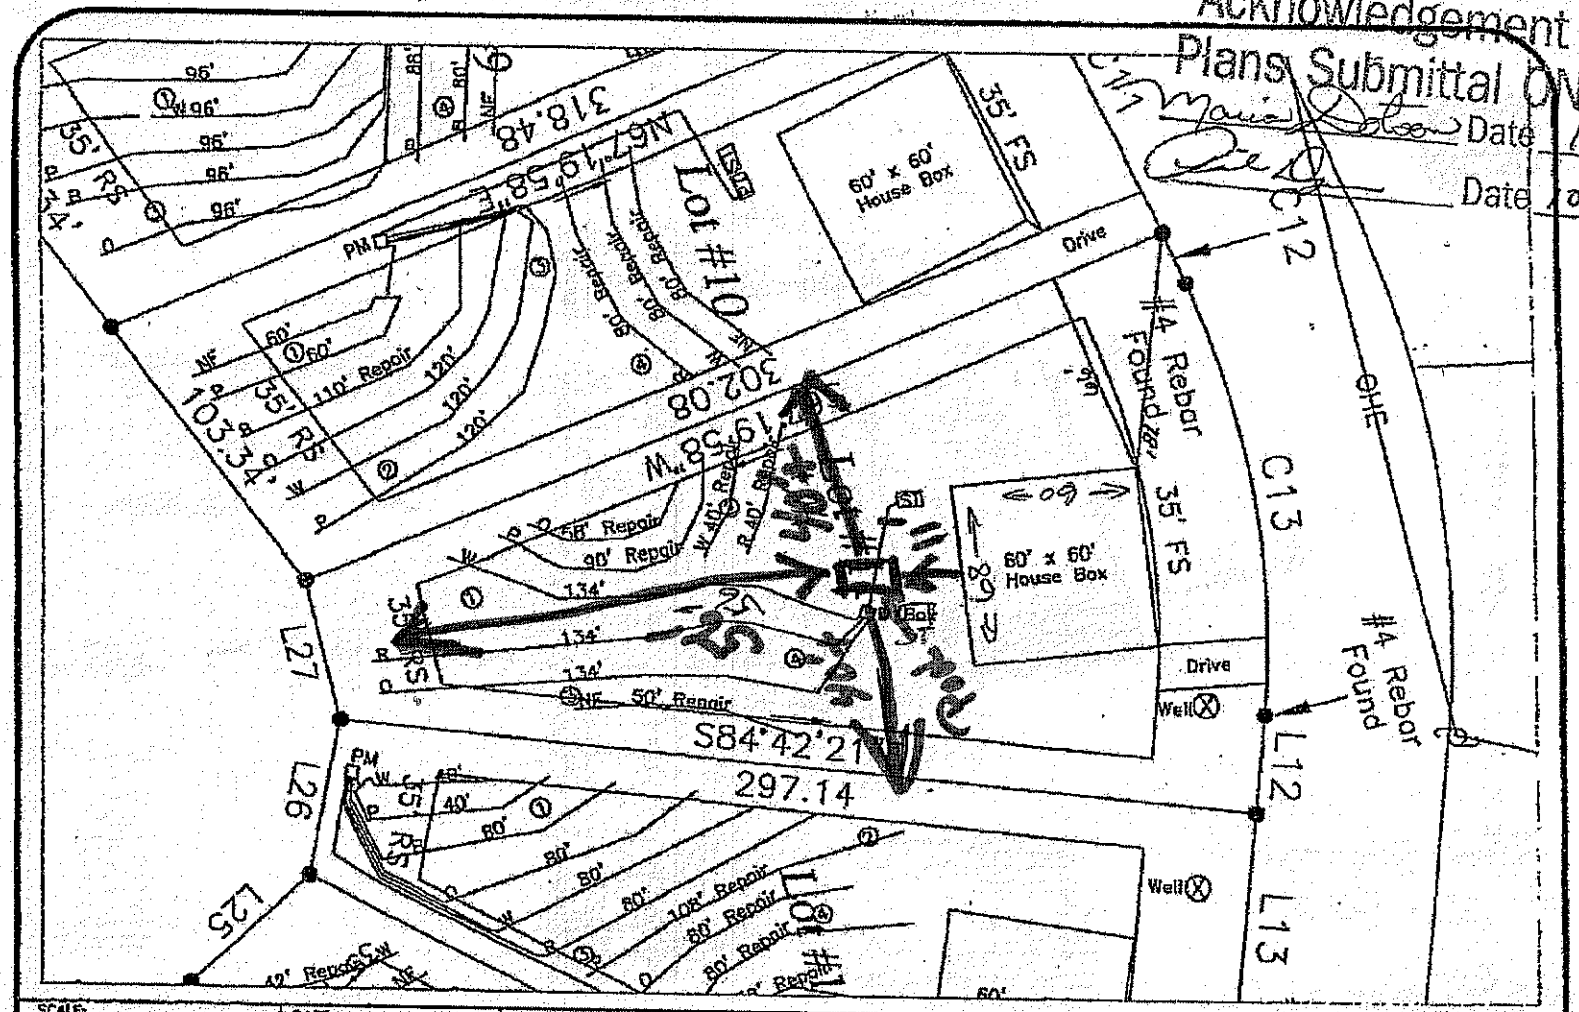

SCALE: 1" = 50'	DATE: March, 2009	S&ME 3716 OLD BATTLEGROUND ROAD GREENSBORO, NC 27410 PH. 336-288-7180 FAX. 336-288-8988 WWW.SMEINC.COM	Lot 11 Fern Leaf Subdivision – Kenway Loop. Iredell County, NC	FIGURE NO. 1
PROJECT NO. 1588-09-012	DRAWN BY: KMS			
	CHECKED BY: PGP			