IREDELL COUNTY HEALTH DEPARTMENT

STATESVILLE 704-878-5305 4638 289896 MOORESVILLE 704-664-5281

IMPROVEMENT PERMIT / CERTIFICATE OF COMPLETION / OPERATION PERMIT / EXISTING SYSTEM INSPECTION

PROPERTY DESCRIPTION NO. 18469 DATE 5/10/94 TAX MAP NO. 2555A 43 Watershed: ☑ Yes ☐ No

OWNER OR CONTRACTOR Mitch Howard PHONE: Business _____ Home 528-6149

ADDRESS Rt 4 Box 251 Mooresville, NC 28115

LOCATION Kenway Loop; Fern Hill to 2nd Kenway Lp., first house on (R) on gravel section

SUBDIVISION _____ BLOCK / SECTION 15 LOT _____ LOT AREA _____ SITE CLASS: _____ DESIGN FLOW _____ L.T.A.R. _____

Septic Tank: 1500 Gallons; STB _____ Date _____

Pump Tank: _____ Gallons; PT _____ Date _____

Pump Make: _____ Model _____ Serial No. _____

Nitrification Field: No Fields 1 Square Feet _____ Linear Feet 150*

No Lines _____ Trench Width _____ Max Trench Bottom Depth _____ Gravel Depth _____

☐ New System ☐ Repair System Type: I, II, (III), IV, V, VI

System Description: EXISTING

Repair System Description: _____

Maintenance Agreement Required: ☐ Yes ☑ No

☑ House/Mod. Home No. Bedrooms 3

☐ Mobile Home No. Bathrooms 2

☐ Business No. Employees _____

☐ Other _____

☐ Slab ☑ Crawl Space ☐ Basement w/plumbing ☐ Basement wo/plumbing

Water Supply:
☐ Individual
☐ Community
☐ Public


Comments:

* 16" PBS DRAINFIELD

LAKE

Comments:

INITIAL SITE SKETCH

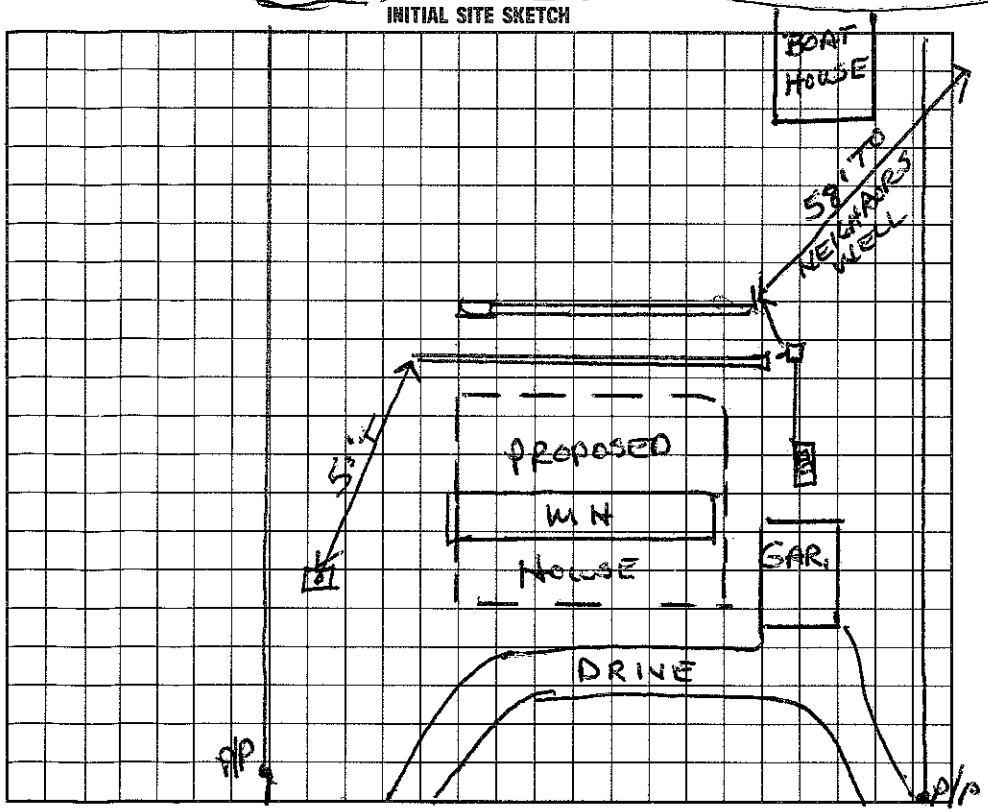

AS BUILT SKETCH

I understand that this permit can be suspended or revoked if any false information is supplied toward securing the permit/any unauthorized changes are made to the site/any unauthorized changes are made in the installation of the system. Improvement Permit is valid for 60 months from date of issuance. KENWAY LP.

Signed: _____

Improvement Permit by: _____ date _____

Existing System Inspection by: Wesley Sparks RS. date 5/10/94

Installed by: _____

Certificate of Completion by: _____ date _____

Operation Permit by: _____ date _____

HEALTH DEPT. COPY: WHITE INSPECTION COPY (FINAL): GREEN OWNER COPY (FINAL): YELLOW INSPECTION COPY (INITIAL): PINK OWNER COPY (INITIAL): GOLD