704-902-9220 C+S Grading 10 3

# IREDELL COUNTY HEALTH DEPARTMENT

STATESVILLE 704-878-5305 MOORESVILLE 704-664-5281

## IMPROVEMENT PERMIT / AUTHORIZATION TO CONSTRUCT / OPERATION PERMIT / EXISTING SYSTEM INSPECTION

PERMIT# 131901 PIN# 4638 29-0995 DATE Nov 8, 05

OWNER OR APPLICANT Nations Land Co, LLC / PRIDE HOMES PHONE: Business _____ Home _____

ADDRESS 4330 Kirtle St SE, Massillon, OH 44646

LOCATION 150 W TR Perth Rd (N) TL FERN HILL Rd. TR Periwinkle 1st lot on left

SUBDIVISION Lakewood Crossing BLOCK / SECTION _____ LOT 11 LOT AREA .94AC SITE CLASS. RS DESIGN FLOW 440gpd L.T.A.R. .3

Septic Tank: 1000 Gallons; STB 1012 Date 2-31-06
Pump Tank: 1000 Gallons; PT 17 Date 8-11-06
Pump Make: Goulds Model WE0712H Serial No. _____
Nitrification Field: No Fields 1 Square Feet 574± Linear Feet *270+
No Lines 3 Trench Width *24" min 36" Max Trench Bottom Depth 36" Gravel Depth _____

☒ New System ☐ Repair ☐ Expansion System Type: I II III IV V VI
System Description: LPPPBPS
Repair System Description: LPPPBPS
Maintenance Agreement Required: ☒ Yes ☐ No

☒ House/Mod. Home No. Bedrooms 4
☐ Mobile Home No. Persons _____
☐ Business No. Employees _____
☐ Other _____

Water Supply: ☒ Individual ☐ Public ☐ Community

☐ Gravity ☒ Pressure ☐ Slab ☒ Crawl Space ☐ Basement w/plumbing ☐ Basement wo/plumbing


Comments:/Conditions:
* SEE PLAN for Specs
Initial site evaluation and system design performed by Rollins Soil and Environmental Services

INITIAL SITE SKETCH

SEE Plan from Rollins Soil and Env. Services

Comments:/Conditions: 10-3-06 gm
ST w/ marker
yellow tuf-tite fitter
Date unclear on ST looks like 2-31-06

AS BUILT SKETCH

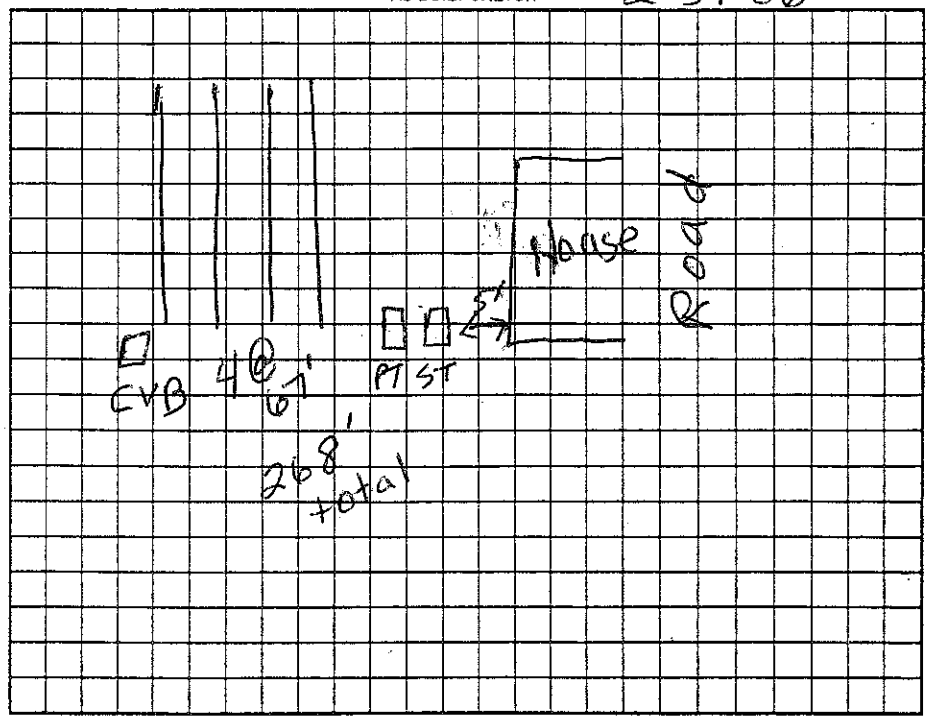


Permit can be suspended or revoked if any false information is supplied toward securing the permit/any unauthorized changes are made to the site/any unauthorized changes are made in the installation of the system. Improvement Permit with plat valid without expiration. ☐ Improvement Permit with site plan valid for sixty months. ☒ Authorization to Construct is valid for a period equal to that of Improvement Permit – not to exceed sixty months.

Signed: Tracey Edmondson date 11-10-05
Improvement Permit by: _____ date 11-8-05
Authorization to Construct by: Wesley Sparks RS date 1/6/05

Installed by: C & S Grading
Operation Permit by: John E. Allen date 11/29/06
Existing System Inspection by: _____ date _____

HEALTH DEPT. COPY: WHITE OWNER COPY (FINAL): YELLOW OWNER COPY (INITIAL): PINK