IREDELL COUNTY HEALTH DEPARTMENT

Authorization to Construct

STATESVILLE 704-878-5305 MOORESVILLE 704-664-5281

IMPROVEMENT PERMIT / ~~CERTIFICATE OF COMPLETION~~ / OPERATION PERMIT / EXISTING SYSTEM INSPECTION

PROPERTY DESCRIPTION NO. 24744 DATE 8/9/96 TAX MAP NO. 25 5A 38 Watershed: X Yes ☐ No

OWNER OR CONTRACTOR Eddie Dunn PHONE: Business (4638299374 Home 662-9306

ADDRESS 325 Barber Loop Mooresville, NC. 28115

LOCATION Perth N, TL Fumble TL Bayba TR ~~Bayba~~ Loop ~.3 mile on (L) Kenway Loop.

SUBDIVISION CL&T BLOCK / SECTION 15 LOT 024 LOT AREA 1.13Ac SITE CLASS. PS DESIGN FLOW 360 L.T.A.R. .3

Septic Tank: 1000 Gallons; STB 824 Date 12/4/96

Pump Tank: _____ Gallons; PT _____ Date _____

Pump Make: _____ Model _____ Serial No. _____

Nitrification Field: No Fields 1 Square Feet 1200 Linear Feet 410

No Lines 4 Trench Width 36" Max Trench Bottom Depth 36" Gravel Depth 12"

X New System ☐ Repair System Type: I. (II) III. IV. V. VI

System Description: CONV - DIST BOX

Repair System Description: SAME

Maintenance Agreement Required: ☐ Yes X No

X House/Mod. Home No. Bedrooms 3

☐ Mobile Home No. Bathrooms 2

☐ Business No. Employees ____

☐ Other _____


☐ Slab X Crawl Space ☐ Basement w/plumbing ☐ Basement wo/plumbing

Water Supply: X Individual ☐ Community ☐ Public


Comments:

Comments:

INITIAL SITE SKETCH

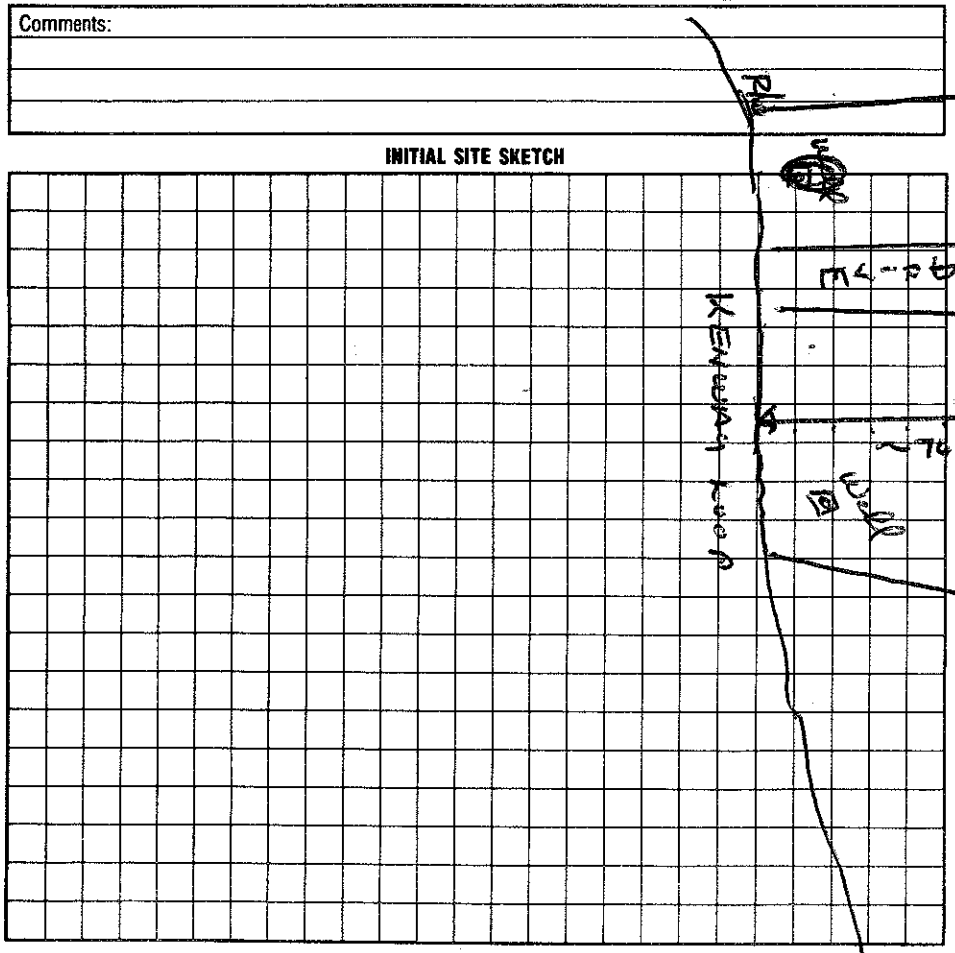

AS BUILT SKETCH

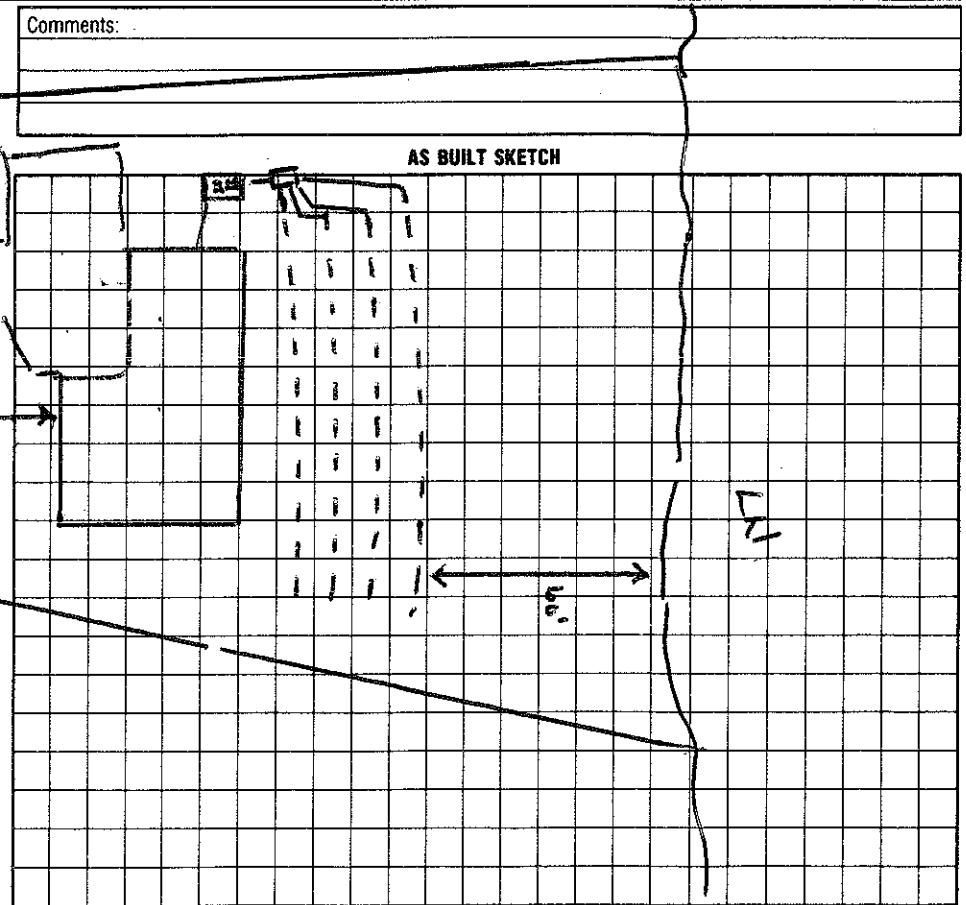

I understand that this permit can be suspended or revoked if any false information is supplied toward securing the permit/any unauthorized changes are made to the site/any unauthorized changes are made in the installation of the system.

Signed: X _____

Improvement Permit by: Wesley Sparks RS. date 8/9/96

Authorization to Construct; Existing System Inspection by: Wesley Sparks RS. date 8/9/96

Installed by: Scott Dent

Certificate of Completion by: _____ date _____

Operation Permit by: Wesley Sparks RS date 1/8/97

HEALTH DEPT. COPY: WHITE INSPECTION COPY (FINAL): GREEN OWNER COPY (FINAL): YELLOW INSPECTION COPY (INITIAL): PINK OWNER COPY (INITIAL): GOLD