4638310562

IREDELL COUNTY HEALTH DEPARTMENT

STATESVILLE 704-878-5305 MOORESVILLE 704-664-5281

IMPROVEMENT PERMIT / CERTIFICATE OF COMPLETION / OPERATION PERMIT / EXISTING SYSTEM INSPECTION

PROPERTY DESCRIPTION NO. 17470 DATE 6/16/95 TAX MAP NO. 2A A4 Watershed: ☐ Yes ☒ No

OWNER OR CONTRACTOR PO Box 596 CRUSOE RD. MOORESVILLE PHONE: Business _____ Home 664-7559

ADDRESS ROGER HERNSBY

LOCATION CRUSOE RD OFF ROBINSON RD 1ST DRIVE ON L, TO REAR OF PROPERTY

SUBDIVISION ROGER HERNSBY BLOCK / SECTION _____ LOT 2 LOT AREA 1.54 AC. SITE CLASS. P DESIGN FLOW 360 L.T.A.R. .3

Septic Tank: 1000 Gallons; STB 794 Date 10/6/95
Pump Tank: _____ Gallons; PT _____ Date _____
Pump Make: _____ Model _____ Serial No. 200 Ams
Nitrification Field: No. Fields 1 Square Feet 1200 Linear Feet ~~300~~ (400)
No Lines ~~X3~~ Trench Width 36" Max Trench Bottom Depth 36" Gravel Depth N/A

☒ New System ☐ Repair System Type: I, II, (III), IV, V, VI
System Description: INFILTRATOR
Repair System Description: _____
Maintenance Agreement Required: ☐ Yes ☒ No

☒ House/Mod. Home ☐ Mobile Home ☐ Business ☐ Other
No. Bedrooms 4 No. Bathrooms 1.5 No. Employees _____
☐ Slab ☒ Crawl Space ☐ Basement w/plumbing ☐ Basement wo/plumbing


Water Supply: ☒ Individual ☐ Community ☐ Public

Comments: ~~X~~ 25% reduction for INFILTRATOR USE


Comments: 3 | 240.0 | 24 | 3 | 900 | 9.6 | .375 | 1350 | 4.5

11/1/95 Changed to 200' on Infiltrator of 3 lines

INITIAL SITE SKETCH

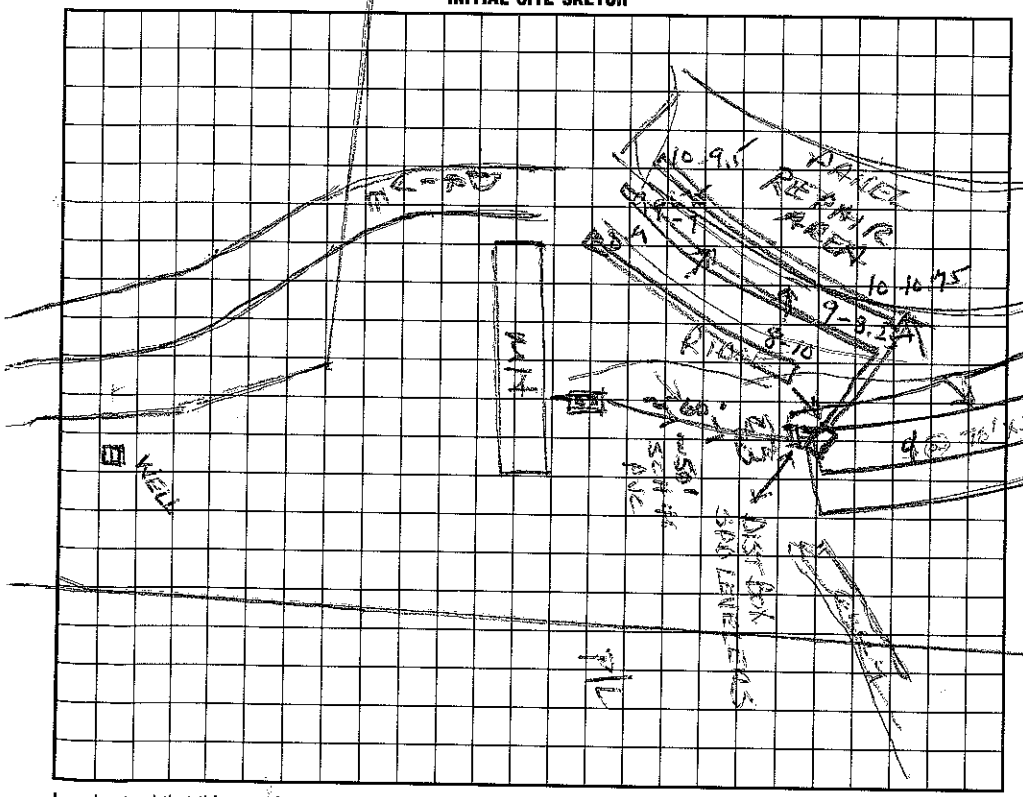

AS BUILT SKETCH

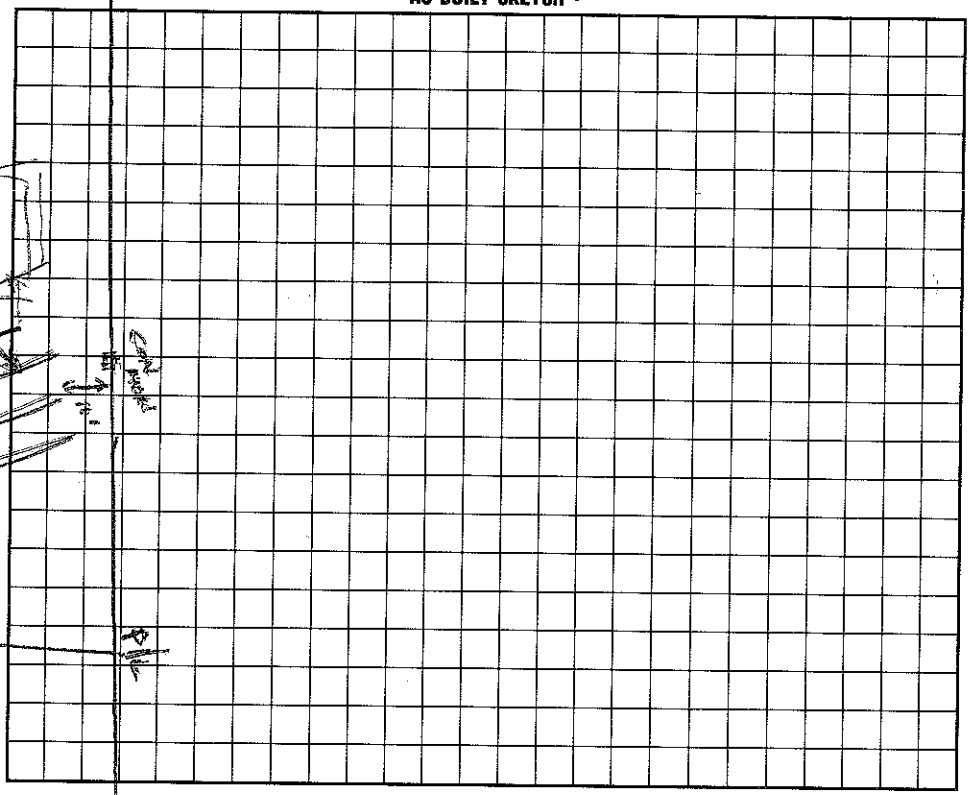

I understand that this permit can be suspended or revoked if any false information is supplied toward securing the permit/any unauthorized changes are made to the site/any unauthorized changes are made in the installation of the system. Improvement Permit is valid for 60 months from date of issuance.

Signed: X Roger Hornsby

Improvement Permit by: Wesley Sparks RS. date 6/16/95

Existing System Inspection by: _____ date _____

Installed by: James Hudler

Certificate of Completion by: _____ date _____

Operation Permit by: Wesley Sparks RS. date 12/14/95

HEALTH DEPT. COPY: WHITE INSPECTION COPY (FINAL): GREEN OWNER COPY (FINAL): YELLOW INSPECTION COPY (INITIAL): PINK OWNER COPY (INITIAL): GOLD