...ENT - ENVIRONMENTAL HEALTH ☐ STATESVILLE OFFICE 704-878-5305 ☐ MOORESVILLE OFFICE 704-664-5281

...THORIZATION TO CONSTRUCT / OPERATION PERMIT / EXISTING SYSTEM INSPECTION

PIN # 4638318601 DATE 12-5-2011

Newton APPLICANT: Same PHONE: Home/Cell # 704528-0810 Business # 704 363-6964

...rkland Ln OWNER / APPLICANT ADDRESS

...w 150 W TR Robinson IL Crusoe IL Backland on right

...es Double BLOCK / SECTION LOT # LOT AREA .46 Acre DESIGN FLOW 240-360g/d T.A.R.

Pun ...00 Gallons: STB Date

Pun Gallons: P T Date

Pump ...ake Model Serial #

No. Nitrification Fields: 1 No. Lines 4 Linear Feet 240'

Trench Width 36" Max. Trench Bottom Depth

Gravel Depth 12"

☐ New System ☐ Repair ☐ Expansion System Type I II III IV V VI

System Description: Gravity -- Conventional

Repair System Description: Modified - Conv.

Maintenance Agreement Required ☐ YES ☒ NO

☐ GRAVITY ☐ PRESSURE

☒ Residence No. Bedrooms 2-3

☐ Business No. Persons

☐ Other No. Employees

☐ Slab ☐ Crawl Space

☐ Basement w/plumbing ☐ Basement w/o plumbing


Water Supply: ☒ Private ☐ Public ☐ Community

Comments / Conditions: Existing Septic System "Appears" to be Functioning okay at time of inspection. No-home was located at site. Septic System has been out of use.

Septic System installed in 1983 for "2-3" Bedrooms

☆Okay to use "Double wide" but Must keep it at least 5Ft off

INITIAL SITE SKETCH

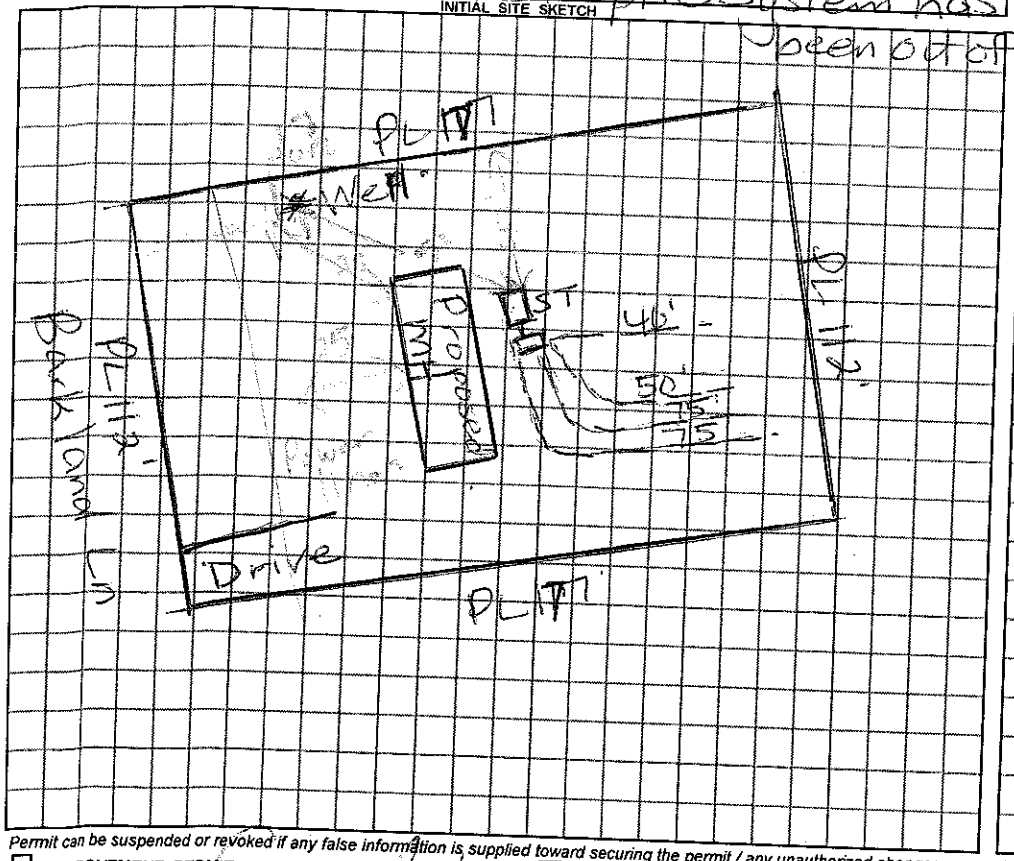

AS BUILT SKETCH

Septic System @ 25' off Well

The proposed / existing Mh. 28'X53 addition does not appear to impact the existing septic system.

**NOTE: Must be at least 5Ft from Septic

@ 25Ft from well

M Dotson B.S.

Date: 11/2/12

ICHD-Environmental Health Division

Permit can be suspended or revoked if any false information is supplied toward securing the permit / any unauthorized changes are made to the site / any unauthorized changes are made in the installation of the system.

☐ ***IMPROVEMENT PERMIT*** with plat valid without expiration.

☐ ***IMPROVEMENT PERMIT*** with ~~plat~~ site plan valid without expiration. site plan valid 60 mo.

☐ ***AUTHORIZATION TO CONSTRUCT*** valid for period equal to IMPROVEMENT PERMIT--not to exceed 60 mo.

Owner / Applicant Signature: per Tel for Date 1-6-12

IMPROVEMENT PERMIT by: REHS Date

AUTHORIZATION TO CONSTRUCT by: REHS Date

YOU SHOULD CONTACT A LOCATOR SERVICE PRIOR TO ANY EXCAVATION

Installed by: China Grove Septic 1983

OPERATION PERMIT by: REHS Date

Existing System Inspected by: M Dotson REHS Date 12/5/11

White Copy -- Environmental Health YELLOW COPY (F...