4638320752

IREDELL COUNTY HEALTH DEPARTMENT

STATESVILLE 704-878-5305 MOORESVILLE 704-664-5281

IMPROVEMENT PERMIT / CERTIFICATE OF COMPLETION / OPERATION PERMIT / EXISTING SYSTEM INSPECTION

PROPERTY DESCRIPTION NO. 17672 DATE 1/20/94 TAX MAP NO. 2P-13-A-14 Watershed: ☐ Yes ☒ No

OWNER OR CONTRACTOR TED MIKELS PHONE: Business _____ Home 664-6989

ADDRESS Rt 4 Box 1008 MOORESVILLE, NC 28115

LOCATION NORMANDY RD. TO END (CULDESAC) ON ☐

SUBDIVISION _____ BLOCK / SECTION _____ LOT 2 LOT AREA ~1.99AC SITE CLASS. P DESIGN FLOW 360 L.T.A.R. .25-.3

Septic Tank: 1000 Gallons; STB "94 Dellinger Date 6-11-94

Pump Tank: _____ Gallons; PT _____ Date _____

Pump Make: _____ Model _____ Serial No. _____

Nitrification Field: No Fields 1 Square Feet 1200 Linear Feet 400

No Lines 3&4 Trench Width 3' Max Trench Bottom Depth 3' Gravel Depth 12

☒ New System ☐ Repair System Type: I, ☒ II, III, IV, V, VI

System Description: DISTBOX - COND.

Repair System Description: SAME

Maintenance Agreement Required: ☐ Yes ☒ No

☒ House/Mod. Home No. Bedrooms 3

☐ Mobile Home No. Bathrooms 2

☐ Business No. Employees _____

☐ Other _____


☐ Slab ☒ Crawl Space ☐ Basement w/plumbing ☐ Basement wo/plumbing

Water Supply: ☒ Individual ☐ Community ☐ Public

Comments: KEEP TRENCHES 36" DEEP TO TRENCH BOTTOM IN DIRECTION SHOWN.

Comments: Drainfield installed on 4 trenches 3'x100' each

INITIAL SITE SKETCH

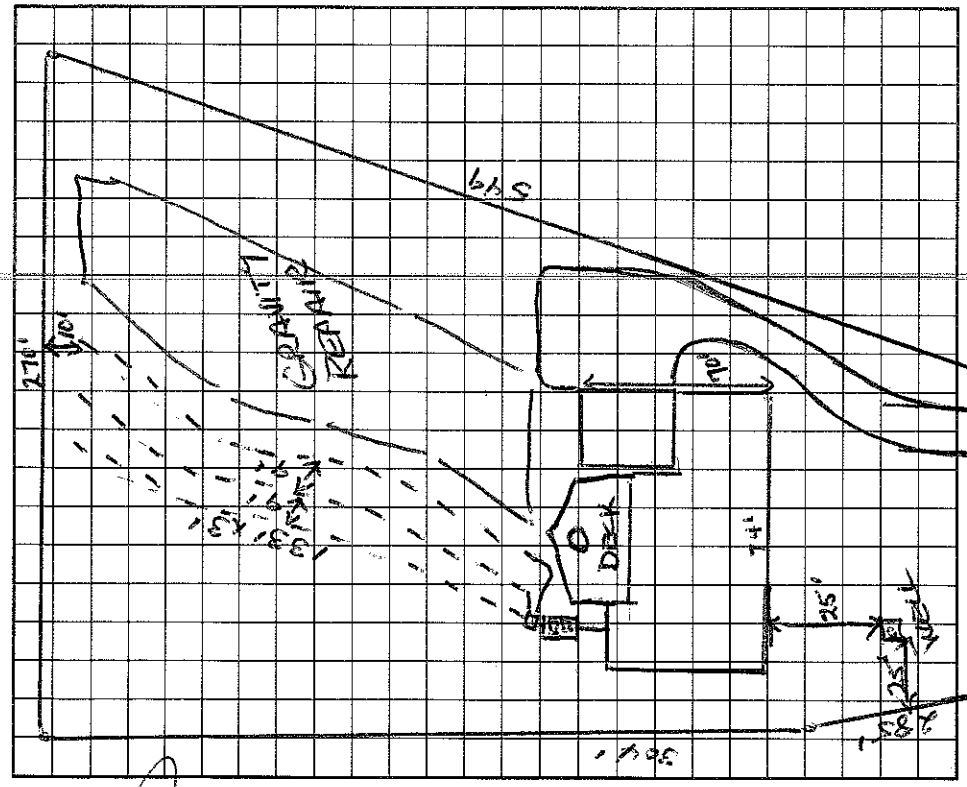

AS BUILT SKETCH

Substantially as shown on initial sketch

I understand that this permit can be suspended or revoked if any false information is supplied toward securing the permit/any unauthorized changes are made to the site/any unauthorized changes are made in the installation of the system. Improvement Permit is valid for 60 months from date of issuance.

Signed: _____

Improvement Permit by: Wesley Sparks RS. date 1/20/94

Existing System Inspection by: _____ date _____

Installed by: J Eaves

Certificate of Completion by: Vince Robinson, RS date 8/2/94

Operation Permit by: _____ date _____

HEALTH DEPT. COPY: WHITE INSPECTION COPY (FINAL): GREEN OWNER COPY (FINAL): YELLOW INSPECTION COPY (INITIAL): PINK OWNER COPY (INITIAL): GOLD