IREDELL COUNTY HEALTH DEPARTMENT

Statesville Office (704) 878-5305 Mooresville Office (704) 660-3625

RA 10:00

PERMIT # 214638

IMPROVEMENT PERMIT / AUTHORIZATION TO CONSTRUCT / OPERATION PERMIT / EXISTING SYSTEM

PIN # 4638324815

APPLICANT: Rollans Soil & Environmental / David APPLICANT ADDRESS: P.O Box 832 Mooresville, NC 28115

SITE ADDRESS: 623 Normandy Rd. - Mark DiLeo Mooresville, NC PHONE: 704 740-5046 ALT. PHONE:

SITE DIRECTIONS: Hwy 150 W TR Perth Rd TL Normandy Rd lot on left

SUBDIVISION: Normandy Hill SECTION: LOT # 12 LOT AREA: DESIGN FLOW: 600gpd L.T.A.R.: .3

Septic Tank 1500 (gal) STB Date

Pump Tank (gal) PT Date

Pump Make Model Serial #

Nitrification Fields 1 # Lines 2 Linear Ft. * 68ft

Trench Width 24" Max. Trench Bottom Depth * 30" Gravel Depth N/A

☐ New System ☐ Repair ☒ Expansion System Type: I II (III) IV V VI

System Description: Gravity PPBPS

Repair System Description: LPP PBPS

Maintenance Agreement Required: ☐ YES ☒ NO

☒ GRAVITY ☐ PRESSURE

☒ Residence ☐ Business ☐ Other ☐ Slab ☐ Basement w/ plumbing

No. Bedrooms 5 No. Persons No. Employees ☒ Crawl Space

☐ Basement w/o plumbing

Water Supply: ☒ Private ☐ Public ☐ Community

Comments / Conditions: * Add 68ft to existing Drainfield. Upgrade ST to 1500 gal (Conventional)

* If existing ST already 1500 gal then existing ST will be ok. JMS

* 30" Initial / 28" Repair

INITIAL SITE SKETCH

See attached/approved plan by Rollans Soil & Environmental dated 10/28/15, approved 11/20/15

AS BUILT SKETCH

Installed as Drawn

Permit can be suspended or revoked if any false information is supplied toward securing the permit / any unauthorized changes are made to the site / any unauthorized changes are made in the installation of the system. **CONTACT A LOCATOR SERVICE PRIOR TO ANY EXCAVATION**

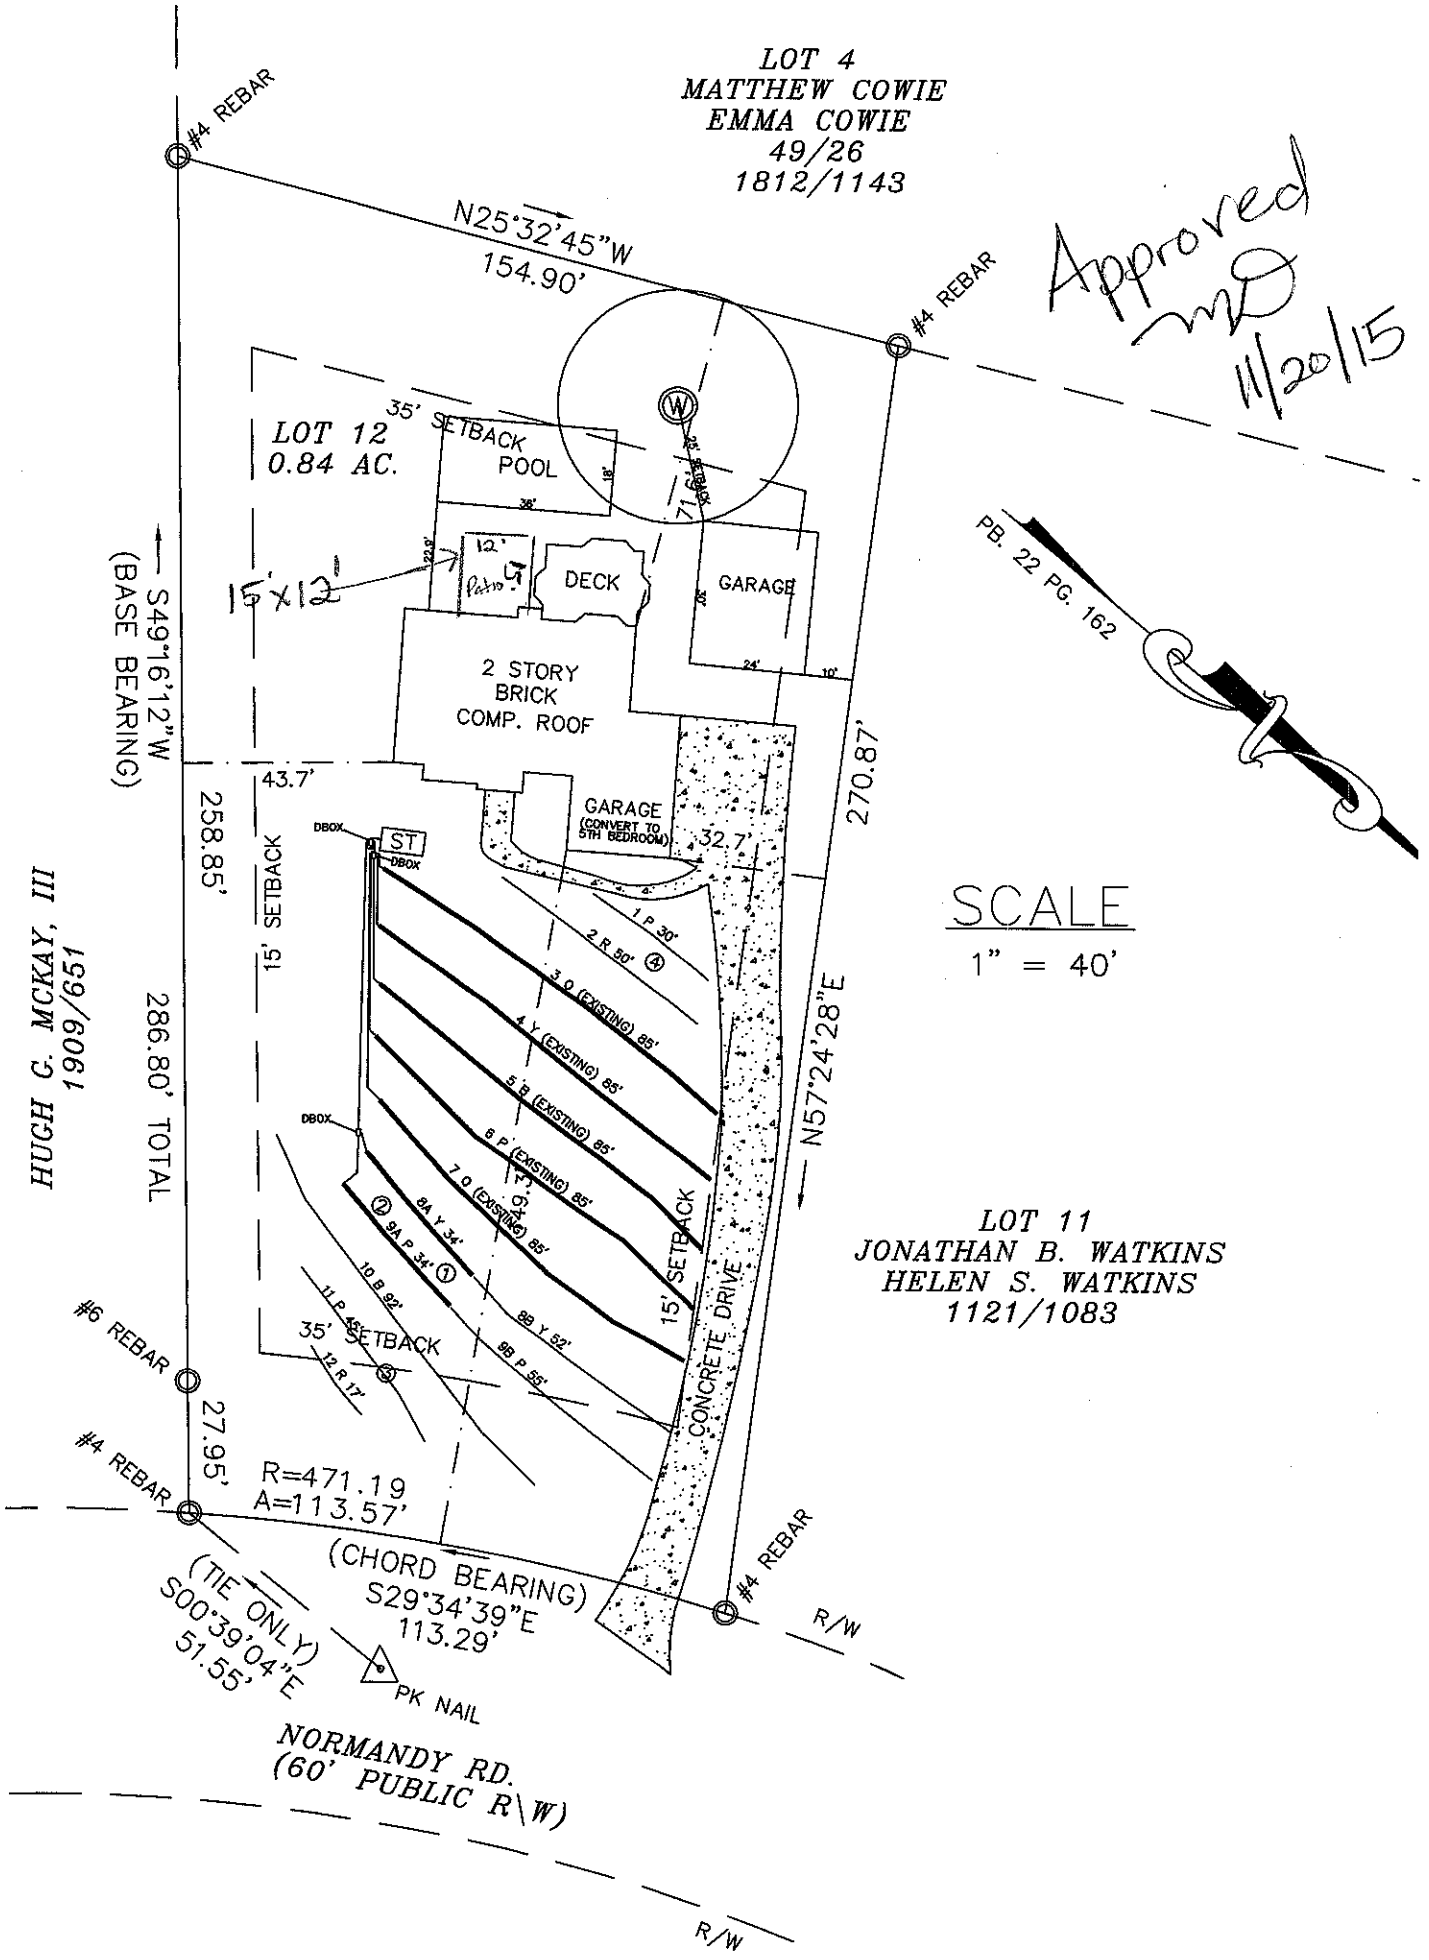
☐ **IMPROVEMENT PERMIT** *with plat valid without expiration.* ☐ **IMPROVEMENT PERMIT** *with site plan valid for 60 mos.* ☐ **AUTHORIZATION TO CONSTRUCT** *valid for period equal to IMPROVEMENT PERMIT--not to exceed 60 mo.*

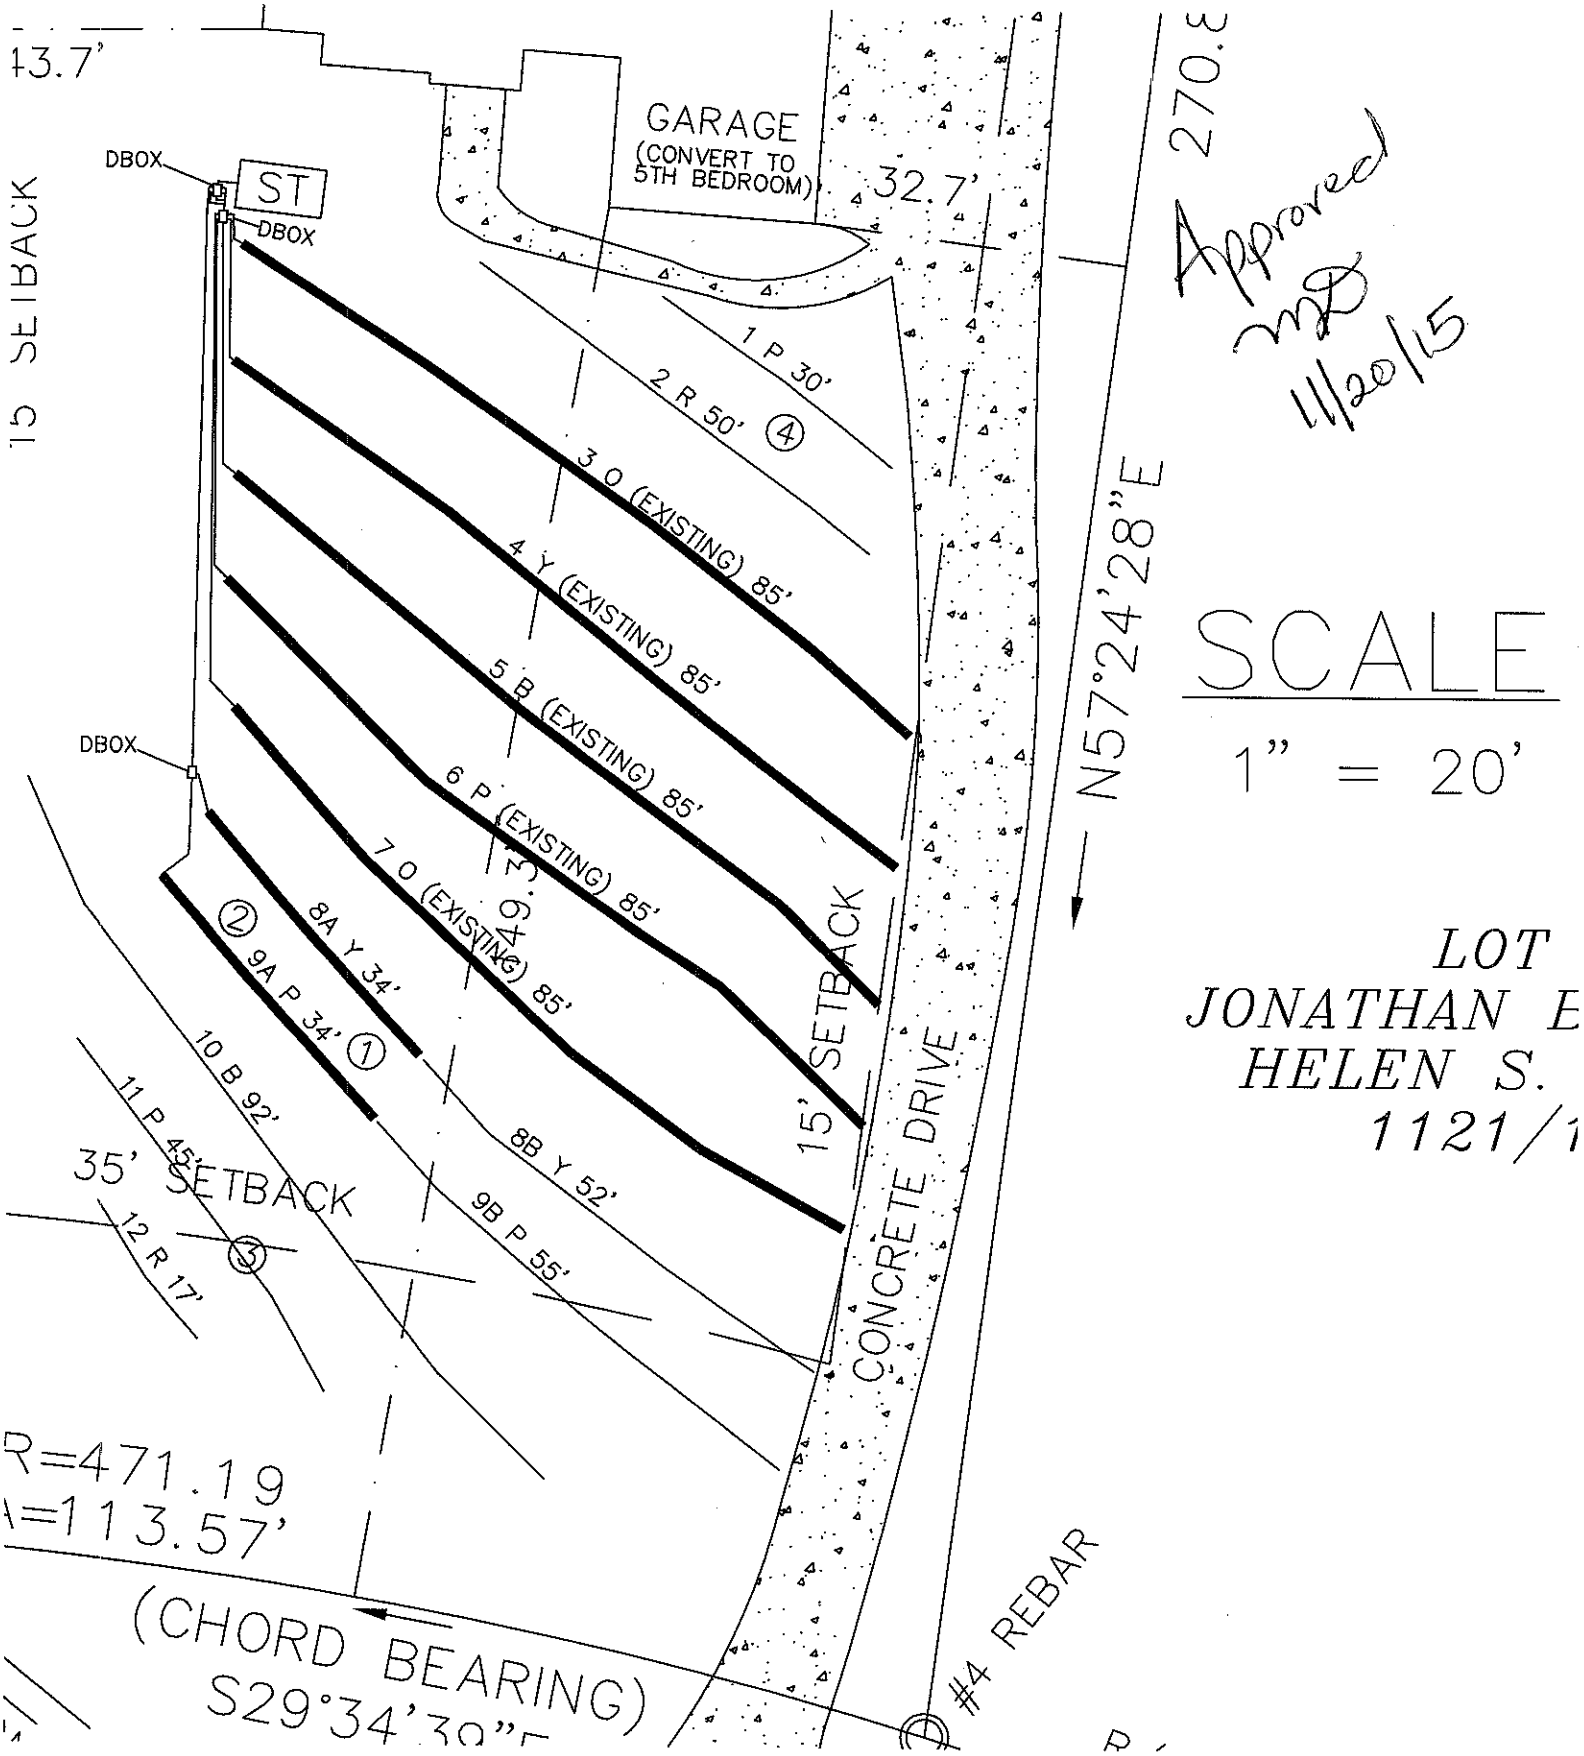
Owner / Applicant Signature: Date: 12/4/15 Installed by: Steve Tedder

IMPROVEMENT PERMIT by: Maria Lotan RS Date: 11/20/15 OPERATION PERMIT by: Maria Lotan RS Date: 4/21/16

AUTHORIZATION TO CONSTRUCT by: Maria Lotan RS Date: 11/20/15 Existing System Inspected by: Date:

Health Dept. Copy - WHITE Applicant (Final Approval) - YELLOW Applicant (Conditional Approval) - PINK


LOT 4
MATTHEW COWIE
EMMA COWIE
49/26
1812/1143
#4 REBAR
N25°32'45"W
154.90'
#4 REBAR
Approved
MD
11/20/15
LOT 12
0.84 AC.
35' SETBACK
POOL
DECK
GARAGE
15'X12'
2 STORY
BRICK
COMP. ROOF
PB. 22 PG. 162
S49°16'12"W
(BASE BEARING)
43.7'
258.85'
GARAGE
(CONVERT TO
5TH BEDROOM)
32.7'
270.87'
SCALE
1" = 40'
DBOX
ST
DBOX
15' SETBACK
1 P 30'
2 R 50' ④
3 Q (EXISTING) 85'
4 Y (EXISTING) 85'
5 R (EXISTING) 85'
6 P (EXISTING) 85'
7 Q (EXISTING) 85'
8A Y 34'
9A P 34' ①
10 B 92'
11 P 45'
12 R 17'
35' SETBACK
15' SETBACK
CONCRETE DRIVE
N57°24'28"E
HUGH C. MCKAY, III
1909/651
286.80' TOTAL
LOT 11
JONATHAN B. WATKINS
HELEN S. WATKINS
1121/1083
#6 REBAR
27.95'
#4 REBAR
R=471.19
A=113.57'
(CHORD BEARING)
S29°34'39"E
113.29'
#4 REBAR
R/W
(TIE ONLY)
S00°39'04"E
51.55'
PK NAIL
NORMANDY RD.
(60' PUBLIC R\W)
R/W


13.7'
15' SETBACK
DBOX
ST
DBOX
GARAGE
(CONVERT TO
5TH BEDROOM)
32.7'
270.3
Approved
MB
11/20/15
1 P 30'
2 R 50' ④
3 O (EXISTING) 85'
4 Y (EXISTING) 85'
5 B (EXISTING) 85'
6 P (EXISTING) 85'
7 O (EXISTING) 85'
8A Y 34'
8B Y 52'
9A P 34' ①
9B P 55'
10 B 92'
11 P 45'
12 R 17'
② ③ ⑤
DBOX
DBOX
N57°24'28"E
SCALE
1" = 20'
15' SETBACK
CONCRETE DRIVE
35' SETBACK
LOT
JONATHAN E
HELEN S.
1121/1
R=471.19
L=113.57'
(CHORD BEARING)
S29°34'30"E
#4 REBAR