ICHD - ENVIRONMENTAL HEALTH DIVISION

Statesville Office (704) 878-5305 | Mooresville Office (704) 660-3625 | PERMIT # AP 322756

SEPTIC: IMPROVEMENT PERMIT / AUTHORIZATION TO CONSTRUCT / OPERATION PERMIT / EXISTING SYSTEM

PIN # 4638-32-6969

APPLICANT/OWNER: Franklin Olsen | APPLICANT ADDRESS: 122 McNaron Ln Mooresville, NC 28117

SITE ADDRESS: 624 Normandy Mooresville, NC 28117 | PHONE: 910 237-5562 | ALT. PHONE

SITE DIRECTIONS: Hwy 150 W TR Perth Rd TL Normandy Rd ~2.25 miles on right past McNaron | SAP CONTROLLED: N/A ☐ YES ☐ NO

SUBDIVISION: CL & T | SECTION: II | LOT # 139 | LOT AREA: .655 Acres | DESIGN FLOW: 360 gpd | L.T.A.R.:

Septic Tank: ~~Exist~~ 1000 (gal)	STB	Date	☐ New System ☐ Repair ☐ Expansion	System Type: I (II) III IV V VI	☒ Residence No. Bedrooms 3
Pump Tank (gal)	PT	Date	System Description: Exist. Gravity – Convent. Gravel		☐ Business No. Persons 6
Pump Make	Model	Serial #	Repair System Description:		☐ Other No. Employees
# Nitrification Fields	# Lines Existing	Linear Ft:	Maintenance Agreement Required: ☐ YES ☒ NO		☐ Slab ☐ Crawl Space
Trench Width	Trench Bottom Depth (Low side)	Gravel Depth	☒ GRAVITY ☐ PRESSURE		☒ Basement w/plumbing ☐ Basement w/o plumbing

Water Supply: ☒ Private ☐ Public ☐ Community


Comments / Conditions: Existing Septic System "appears" to be functioning ok at time of inspection. However due to the age of the Septic System it may to be replaced soon.

Original Drainfield in front of house was abandoned in 1989

5-2-23. - Floor plan - Reviewed. - Home to be placed as permitted.

INITIAL SITE SKETCH

Scale 1:60

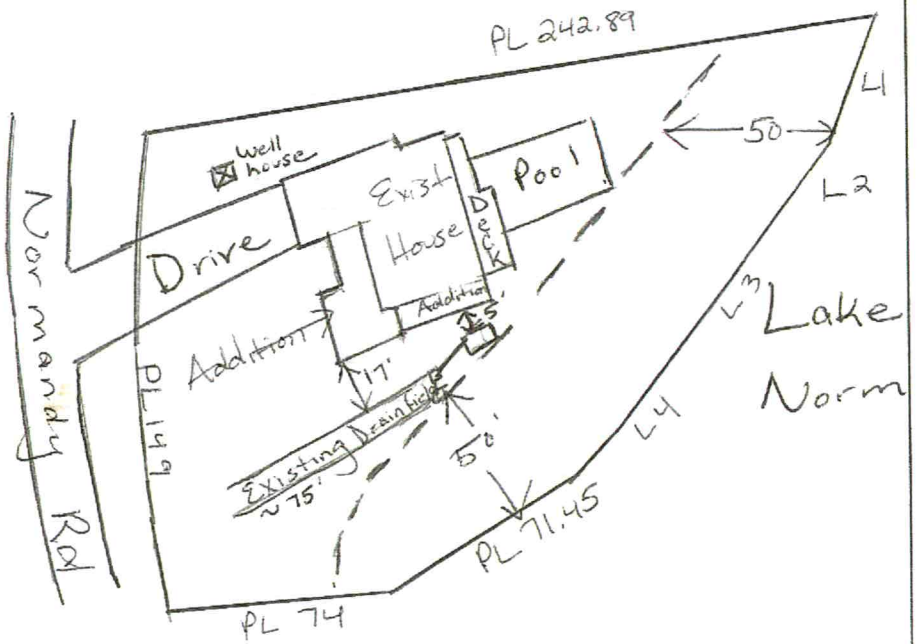

AS BUILT SKETCH

FOR SEPTIC FINAL INSPECTION CALL: 704-664-3703 between 8am-9am the day the inspection is needed. Be sure to speak with an inspector to confirm your time.

Permit can be suspended or revoked if any false information is supplied toward securing the permit / any unauthorized changes are made to the site / any unauthorized changes are made in the installation of the system. **CONTACT A LOCATOR SERVICE PRIOR TO ANY EXCAVATION**

☐ **IMPROVEMENT PERMIT** *with plat valid without expiration.* ☐ **IMPROVEMENT PERMIT** *with site plan valid for 60 mos.* ☒ **AUTHORIZATION TO CONSTRUCT** *valid for period equal to IMPROVEMENT PERMIT--not to exceed 60 mo.*


Owner / Applicant Signature: [signature] Date: 6/14/22 | Installed by: FJ Errin 11/14/1989

IMPROVEMENT PERMIT by: Date: | OPERATION PERMIT by: Date:

AUTHORIZATION TO CONSTRUCT by: Date: | Existing System Inspected by: Maria Dobson Date: 6/2/22

FOR SEPTIC FINAL INSPECTION: CALL 704-664-3703 between 8am-9am the day the inspection is needed.

REVISED 3/17/23

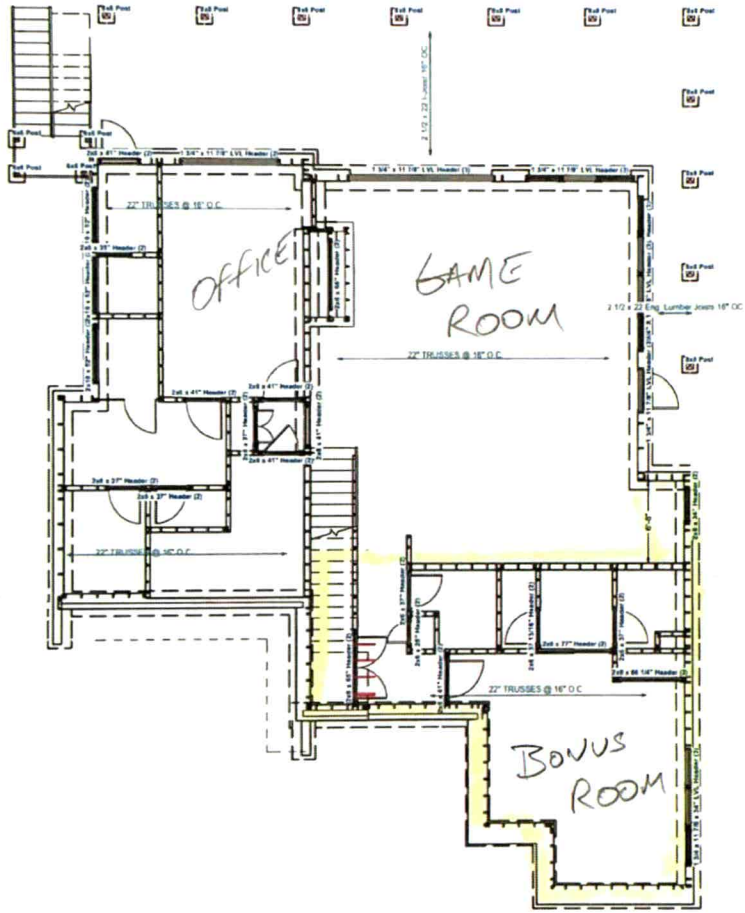

5/2/23 BB

FRAMING PLAN - BASEMENT

SCALE: 1/4" = 1'

OLSEN REMODEL
624 Normandy Road
Mooresville, NC 28117

FRAMING PLAN - BASEMENT


DRAWINGS PROVIDED BY

DATE: 3/17/2023


SCALE: AS NOTED

SHEET: S-112

REVISED 3/17/23

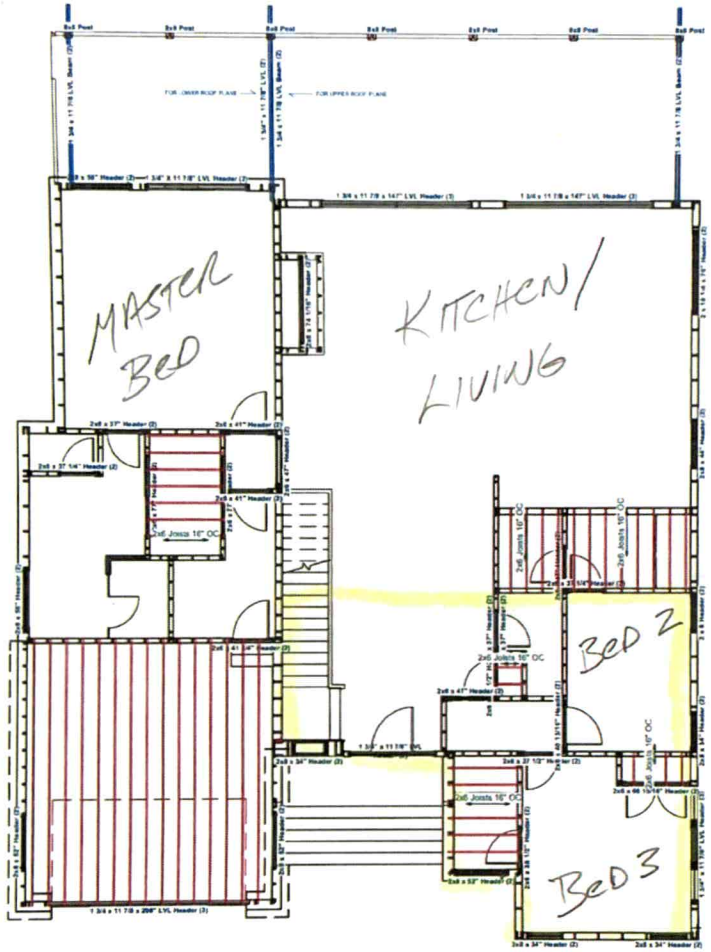

FRAMING PLAN - MAIN FLOOR
SCALE: 1/4" = 1'

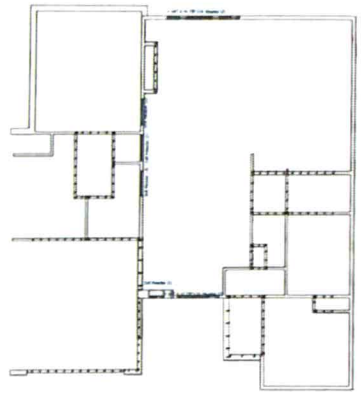

FRAMING PLAN - UPPER
SCALE: 1/8" = 1'

5/2/23 BB

OLSEN REMODEL
624 Normandy Road
Mooresville, NC 28117

FRAMING PLAN - MAIN FLOOR

DRAWINGS PROVIDED BY:

DATE: 3/17/2023

SCALE: AS NOTED

SHEET: S-113

BLDR-2023-23451
Revised 4/27/23
(EnerGov)

