IREDELL COUNTY HEALTH DEPARTMENT

STATESVILLE 704-878-5305 MOORESVILLE 704-664-5281

IMPROVEMENT PERMIT / AUTHORIZATION TO CONSTRUCT / OPERATION PERMIT / EXISTING SYSTEM INSPECTION

PERMIT# 155786 PIN# ~~4638510677.001~~ 4638329468 DATE 5-12-2010

OWNER OR CONTRACTOR Scott Allegretto (Chad Gaddin) PHONE: Business 646 246 9692 Home 704 799-9770

ADDRESS 175 Carriage Club Dr. Mooresville, NC 28117

LOCATION Hwy 150 W) TR Perth Rd TL Normandy near end on left

SUBDIVISION Normandy Creek LOCK / SECTION ____ LOT 1 LOT AREA 1.869Ac SITE CLASS 1 PS DESIGN FLOW 480gpd L.T.A.R. .25

Septic Tank: 1000 Gallons; STB 794 Date 2-17-11

Pump Tank: 1000 Gallons; PT 294 Date ~~10-10-10~~

Pump Make: ____ Model ____ Serial No. ____

Nitrification Field: No Fields 1 Square Feet 708+ Linear Feet 354'

No Lines 6 Trench Width 36" Max Trench Bottom Depth 36"

☒ New System ☐ Repair System Type: I, II, III, IV, V, VI

System Description: Pump-LP-Panel Blk

Repair System Description: Same

Maintenance Agreement Required: ☐ Yes ☐ No

Gravel Depth N/A ☐ Slab ☒ Crawl Space ☐ Basement w/plumbing ☐ Basement wo/plumbing


☒ House/Mod. Home ☐ Mobile Home ☐ Business ☐ Other

No. Bedrooms 4 No. Bathrooms ____ No. Employees ____

Water Supply: ☒ Individual ☐ Public ☐ Community

Comments/Conditions:
Scale 1:60


INITIAL SITE SKETCH

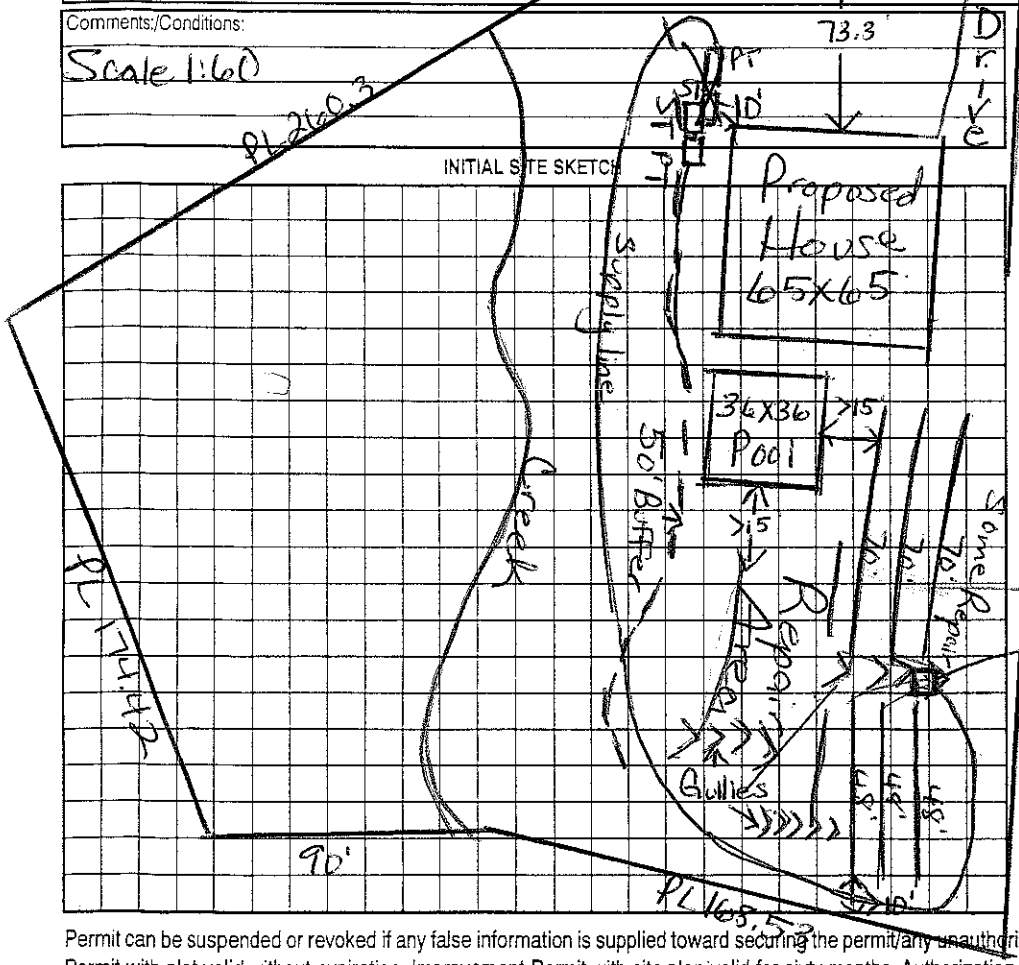

Comments/Conditions:
Potential well location ✱320' linear ft of Drainfie
Must keep Septic 100ft to well & 50ft from creek ✱ Use in-line filter in PT
Refer 4/19/11 Checked tanks & lines

AS BUILT SKETCH

This permit replaces previous permit dated 4/26/09
10/25/2010 Reviewed Floor plans, in compliance with IP.
✱ Drilled 5/32" hole

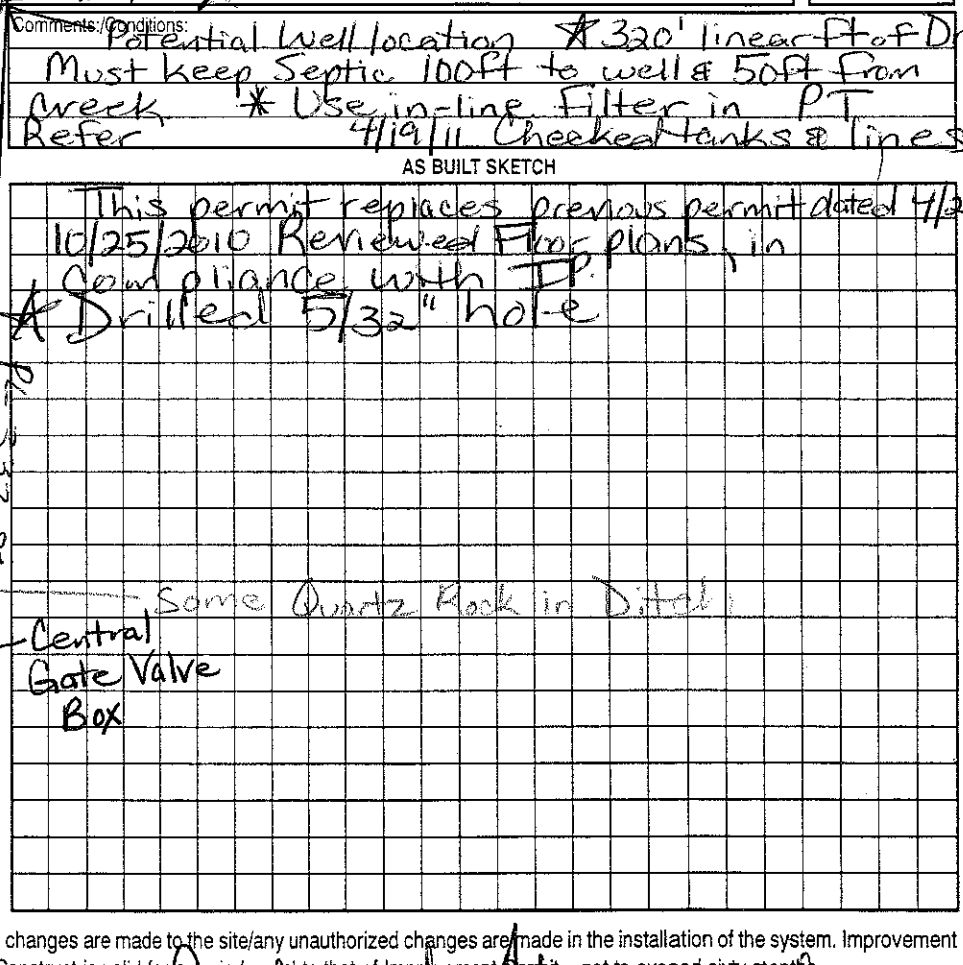

Permit can be suspended or revoked if any false information is supplied toward securing the permit/any unauthorized changes are made to the site/any unauthorized changes are made in the installation of the system. Improvement Permit with plat valid without expiration. Improvement Permit with site plan valid for sixty months. Authorization to Construct is valid for a period equal to that of Improvement Permit – not to exceed sixty months.

Signed: Doreen Allegretto date 5/18/2010 Installed by: Richard Abernathy

Improvement Permit by: Maria H. Nelson REHS date 5/13/2010 Operation Permit by: RA REHS date 6-20-11

Authorization to Construct by: Maria H. Nelson REHS date 10/25/10 Existing System Inspection by: ____ date ____

HEALTH DEPT. COPY: WHITE OWNER COPY (FINAL): YELLOW OWNER COPY (INITIAL): PINK