(1:30)

IREDELL COUNTY HEALTH DEPARTMENT

STATESVILLE 704-878-5305 MOORESVILLE 704-664-5281

IMPROVEMENT PERMIT / AUTHORIZATION TO CONSTRUCT / OPERATION PERMIT / EXISTING SYSTEM INSPECTION

PERMIT# 22235 PIN# 4638-33-1419 DATE 4/8/98

OWNER OR CONTRACTOR SAM & DUNCAN WASHAM PHONE: Business 663-6763 Home

ADDRESS PO BOX 1453 MOORESVILLE NC 28115

LOCATION HWY 150 - TR PERTH - TL NORMANDY - LOT ON LT NEAR END

SUBDIVISION NORMANDY HILLS BLOCK / SECTION LOT 6 LOT AREA 1 SITE CLASS. PS DESIGN FLOW 360 L.T.A.R. .3

Septic Tank: 1000 Gallons; STB 794 Date 6/16/98
Pump Tank: Gallons; PT Date
Pump Make: Model Serial No.
Nitrification Field: No Fields 1 Square Feet 900 Linear Feet 300
No Lines 4@75' Trench Width 36" Max Trench Bottom Depth 36" Gravel Depth N/A

☑ New System ☐ Repair System Type: I, II, III, IV, V, VI
System Description: GRAVITY CHAMBERFORMS
Repair System Description: GRAVITY PANEL
Maintenance Agreement Required: ☐ Yes ☑ No


☑ House/Mod. Home No. Bedrooms 3
☐ Mobile Home No. Bathrooms 2
☐ Business No. Employees
☐ Other
☐ Slab ☑ Crawl Space ☐ Basement w/plumbing ☐ Basement wo/plumbing

Water Supply: ☑ Individual ☐ Public ☐ Community

Comments:/Conditions:

Comments:/Conditions: Last line approx 10' from Prop. Corner. Well not installed at time of inspection

INITIAL SITE SKETCH

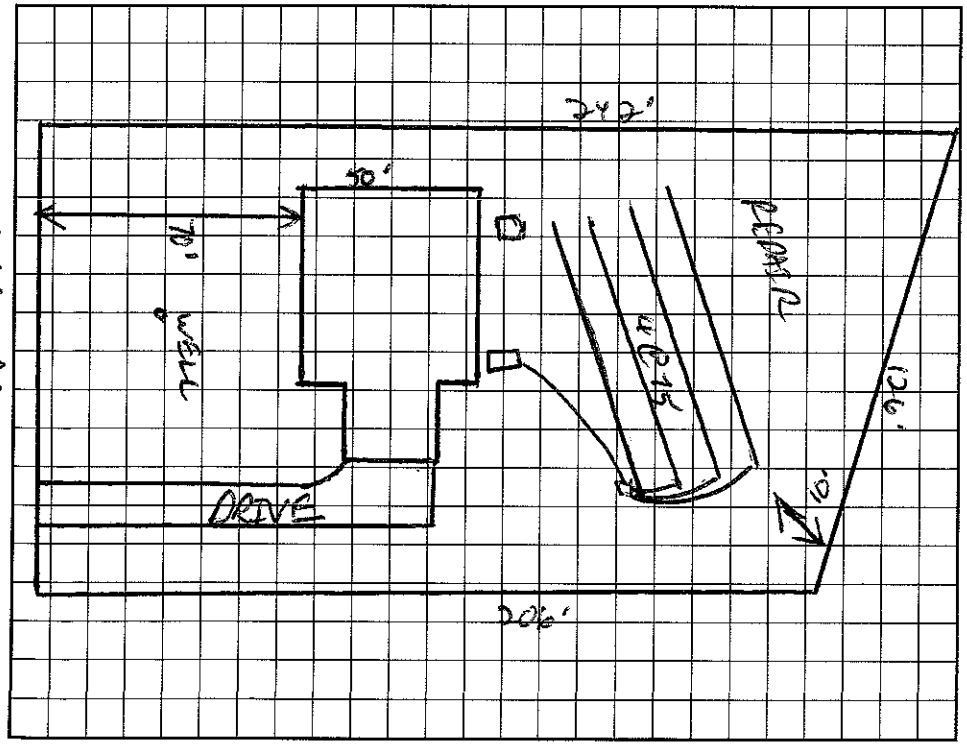

AS BUILT SKETCH

Installed as Shown except 3-100 lines

I understand that this permit can be suspended or revoked if any false information is supplied toward securing the permit/any unauthorized changes are made to the site/any unauthorized changes are made in the installation of the system. Improvement Permit with plat valid without expiration. Improvement Permit with site plan valid for sixty months. Authorization to Construct is valid for a period equal to that of Improvement Permit – not to exceed sixty months.

Signed: date 4/16/98 Installed by: B.W Christenbury

Improvement Permit by: date 4/8/98 Operation Permit by: date 8/25/98

Authorization to Construct by: date 4/8/98 Existing System Inspection by: date 8/25/98

HEALTH DEPT. COPY: WHITE INSPECTION COPY (FINAL): GREEN OWNER COPY (FINAL): YELLOW INSPECTION COPY (INITIAL): PINK OWNER COPY (INITIAL): GOLD