IREDELL COUNTY HEALTH DEPARTMENT

STATESVILLE 704-878-5305 MOORESVILLE 704-664-5281

IMPROVEMENT PERMIT / AUTHORIZATION TO CONSTRUCT / OPERATION PERMIT / EXISTING SYSTEM INSPECTION

PERMIT# 076746 PIN# 4638 33 1817 DATE 11/4/98

OWNER OR CONTRACTOR Arthur S. Francis III PHONE: Business 309-0268 Home

ADDRESS 666 Normandy Rd. Mooresville, NC. 28115

LOCATION Normandy Rd. 1/10 to 666 on (R)

SUBDIVISION CL+T BLOCK / SECTION 11 LOT 146 LOT AREA ~.9Ac SITE CLASS PS DESIGN FLOW 360 L.T.A.R. .25

Septic Tank: 1000 Gallons; STB 794 Date 8-1-8-99
Pump Tank: 1000 Gallons; PT 27 Date 4-3/-99
Pump Make: Model Serial No.
Nitrification Field: No Fields 1 Square Feet 1080 Linear Feet 360
No Lines 6 Trench Width 36" Max Trench Bottom Depth 32" Gravel Depth SAND.

☒ New System ☐ Repair System Type: I, II, (III), IV, V, VI
System Description: Pres. Manifold - CH. Plastic
Repair System Description: Pressure T+I Panels
Maintenance Agreement Required: ☐ Yes ☒ No


☒ House/Mod. Home ☐ Mobile Home ☐ Business ☐ Other
No. Bedrooms 3 No. Bathrooms 2.5 No. Employees
☐ Slab ☐ Crawl Space ☒ Basement w/plumbing ☐ Basement wo/plumbing

Water Supply: ☒ Individual ☐ Public ☐ Community


Comments:/Conditions:

Comments:/Conditions: 3

INITIAL SITE SKETCH

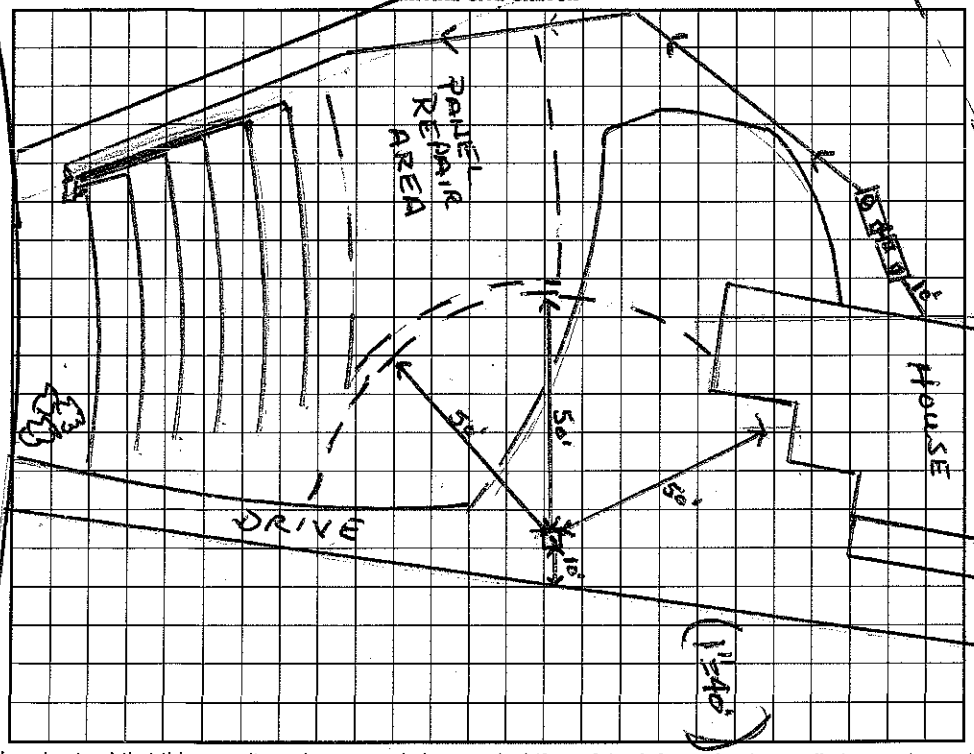

AS BUILT SKETCH

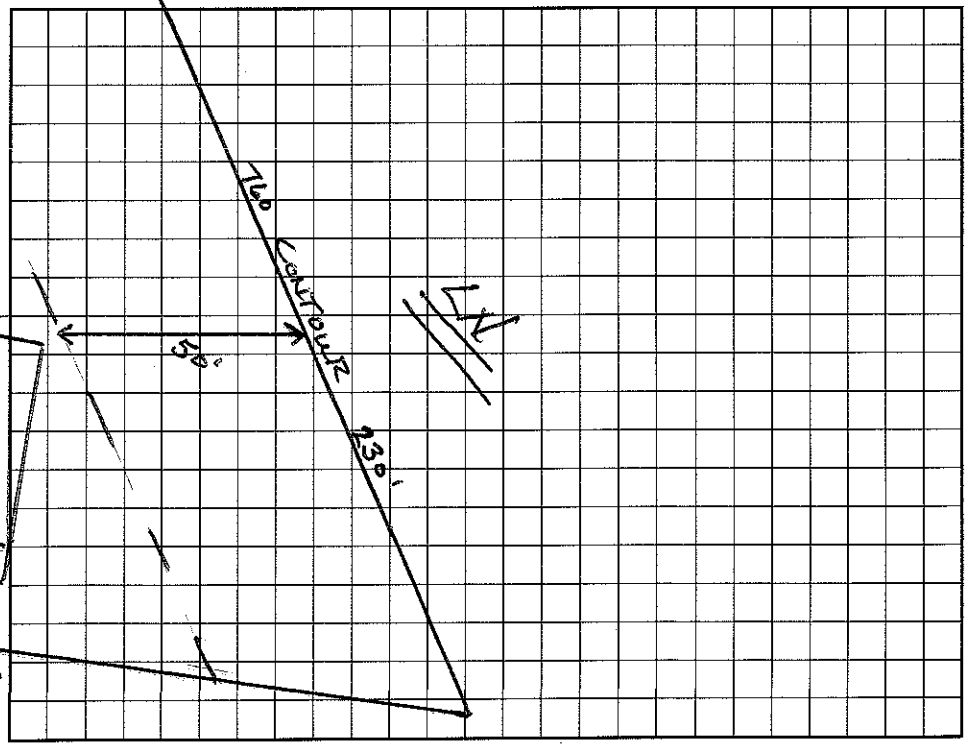

I understand that this permit can be suspended or revoked if any false information is supplied toward securing the permit/any unauthorized changes are made to the site/any unauthorized changes are made in the installation of the system. Improvement Permit with plat valid without expiration. Improvement Permit with site plan valid for sixty months. Authorization to Construct is valid for a period equal to that of Improvement Permit – not to exceed sixty months.

Signed: Curt McCubbin date 11/10/98

Improvement Permit by: Wesley Sparks RS. date 11/4/98

Authorization to Construct by: Wesley Sparks RS. date 11/4/98

Installed by: R + H Enc.

Operation Permit by: Jeff Myers date 6/10/99

Existing System Inspection by: date

HEALTH DEPT. COPY: WHITE INSPECTION COPY (FINAL): GREEN OWNER COPY (FINAL): YELLOW INSPECTION COPY (INITIAL): PINK OWNER COPY (INITIAL): GOLD