IREDELL COUNTY HEALTH DEPARTMENT

STATESVILLE 704-878-5305 MOORESVILLE 704-664-5281

IMPROVEMENT PERMIT / CERTIFICATE OF COMPLETION / OPERATION PERMIT / EXISTING SYSTEM INSPECTION

PROPERTY DESCRIPTION NO. 20827 DATE 4/21/95 TAX MAP NO. 2P-13-A-8

OWNER OR CONTRACTOR Ken Hoffmann ~~PHONE: Business~~ 4638-33-2227 Home 594-2615

ADDRESS 7204 Leahes Ln. Charlotte, NC. 28213

LOCATION Normandy Rd. on (R) upon end of road ~.3mile

SUBDIVISION Normandy Hills BLOCK / SECTION ____ LOT 8 LOT AREA ~.74Ac SITE CLASS. P. L.T.A.R. .35

Water Supply: ☑ Individual ☐ Community ☐ Public

Septic Tank: 1000 Gallons; STB 994 Date 12/12/95

Pump Tank: ____ Gallons; PT ____ Date ____

Nitrification Field: No. Fields 1 Square Feet 1028 Linear Feet ~~350~~ 262

No Lines 5 Trench Width 36" Trench Depth 36" Gravel Depth 12"

☑ New System ☐ Repair System Type: I, II, (II) IV, V, VI

System Description: DIST BOX

Repair System Description: Pressure Panel

Maintenance Agreement Required: ☐ Yes ☑ No

☑ House/Mod. Home No. Bedrooms 3 Garbage Disposal: ☐ Yes ☑ No

☐ Mobile Home No. Bathrooms 2½ Auto. Dishwasher: ☑ Yes ☐ No

☐ Business No. Employees ____ Auto. Washing Machine: ☑ Yes ☐ No

☐ Other ____ Other ____

☐ Slab ☐ Crawl Space ☑ Basement w/plumbing ☐ Basement wo/plumbing


Comments Follow contours in direction

2/23/96 - 5 lines of Chambered Plastic AWS.


36@100 26@50

2/27/96 Inspected all pert top line - AWS

INITIAL SITE SKETCH

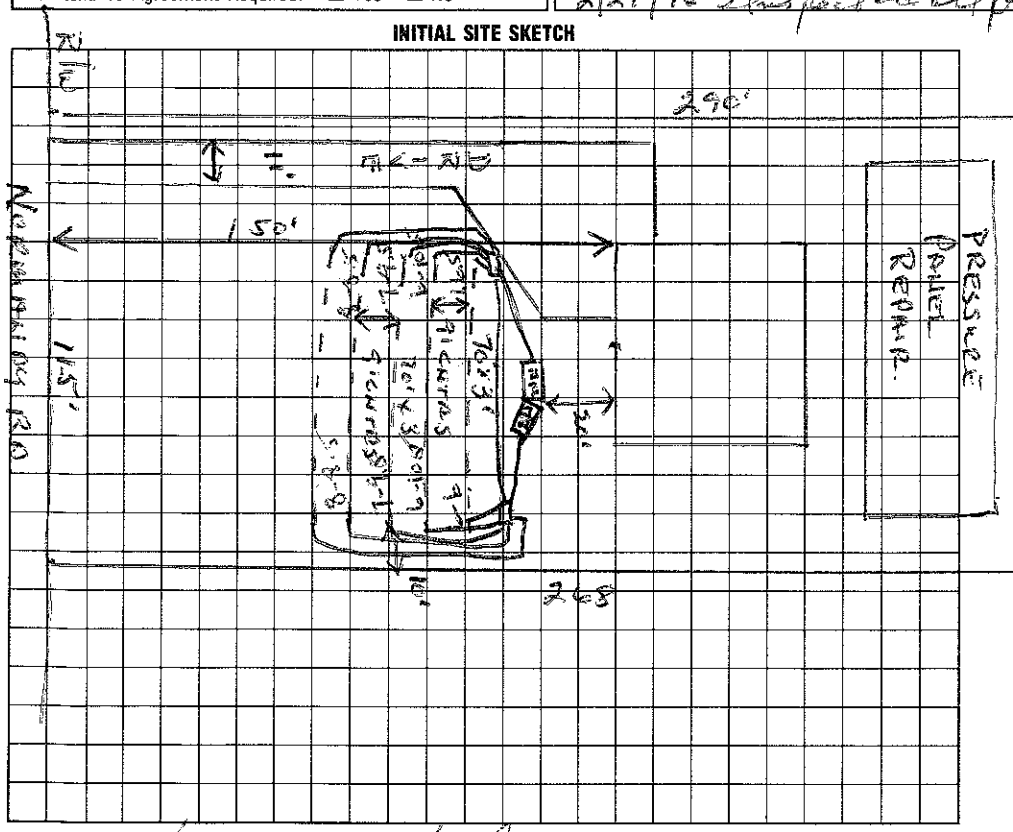

AS BUILT SKETCH

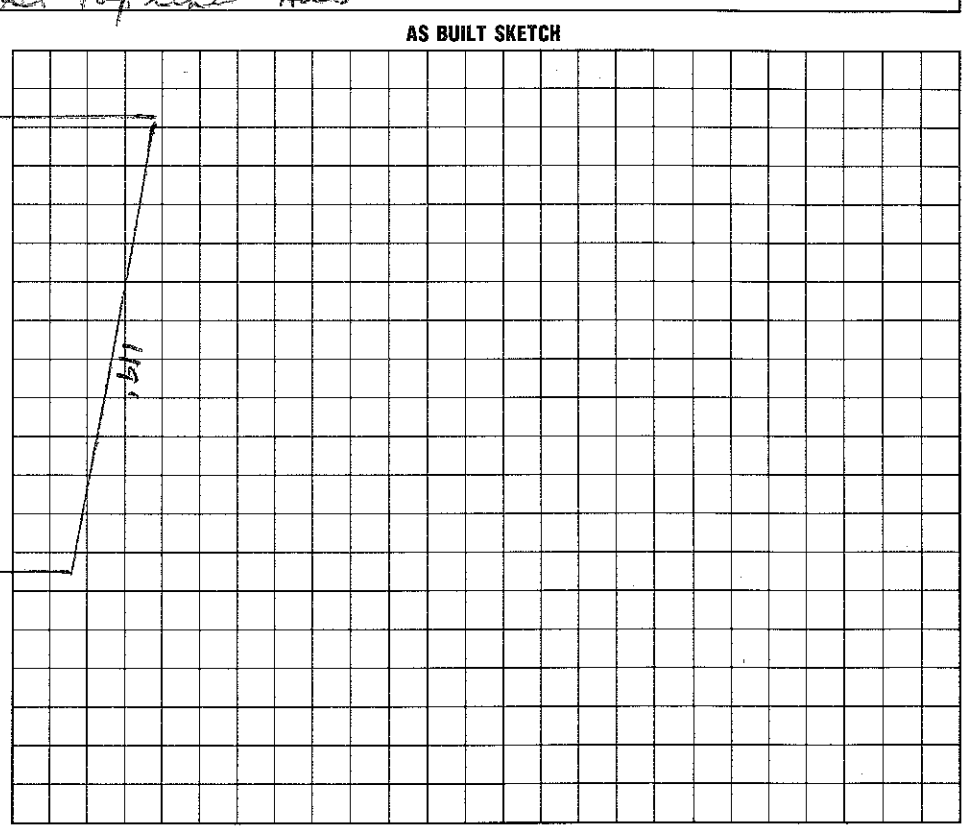

I understand that this permit can be suspended or revoked if any false information is supplied toward securing the permit/any unauthorized changes are made to the site/any unauthorized changes are made in the installation of the system. Improvement Permit is valid for 60 months from date of issuance.

Signed: X Kenneth M Hoffmann

Improvement Permit by: Wesley Sparks RS. date 4/21/95

Existing System Inspection by: ____ date ____

Installed by: F J Ewin

Certificate of Completion by: Wesley Sparks RS. date 2/28/96

Operation Permit by: Wesley Sparks R.S. date 2/28/96

HEALTH DEPT. COPY: WHITE INSPECTION COPY (FINAL): GREEN OWNER COPY (FINAL): YELLOW INSPECTION COPY (INITIAL): PINK OWNER COPY (INITIAL): GOLD