IREDELL COUNTY HEALTH DEPARTMENT

STATESVILLE 704-878-5305 MOORESVILLE 704-664-5281

IMPROVEMENT PERMIT / CERTIFICATE OF COMPLETION / OPERATION PERMIT / EXISTING SYSTEM INSPECTION

PROPERTY DESCRIPTION NO. 15026 DATE 7/1/93 4638-33-3027 TAX MAP NO. 2P-13-A10

OWNER OR CONTRACTOR RICHARD KRAUSHAAR PHONE: Business 563-7488 Home

ADDRESS NORMANDY RD MOORESVILLE

LOCATION NORMANDY, TL OFF PERTH(N) TO LOT ON (L) ~.1 MILE BEFORE CULDESAC

SUBDIVISION NORMANDY HILL BLOCK / SECTION LOT 10 LOT AREA ~20,000FT² SITE CLASS. P L.T.A.R. .35-.4

Water Supply: ☑ Individual ☐ Community ☐ Public

Septic Tank: 1500 Gallons; STB 797 Date 4/7/93

Pump Tank: Gallons; PT Date

Nitrification Field: No Fields 1 Square Feet ~~320~~ Linear Feet 320

No Lines 4 Trench Width 36" Trench Depth 36" Gravel Depth 12"

☑ New System ☐ Repair System Type: I, (II), II, IV, V, VI

System Description: CONV - DIST BOX

Repair System Description: CONV

Maintenance Agreement Required: ☐ Yes ☑ No

☑ House/Mod. Home No. Bedrooms 3

☐ Mobile Home No. Bathrooms 2.5

☐ Business No. Employees

☐ Other

☐ Slab ☑ Crawl Space ☐ Basement w/plumbing ☐ Basement wo/plumbing

Garbage Disposal: ☑ Yes ☐ No

Auto. Dishwasher: ☑ Yes ☐ No

Auto. Washing Machine: ☑ Yes ☐ No

Other

Comments KEEP DRIVE OFF DRAINFIELD! LINES ARE SHALLOW!!

INITIAL SITE SKETCH

The proposed / existing Pool addition does not appear to impact the existing septic system.


**NOTE:

Judy Melvill R.S.

Date: 6-19-12

ICHD-Environmental Health Division

112' AS BUILT SKETCH

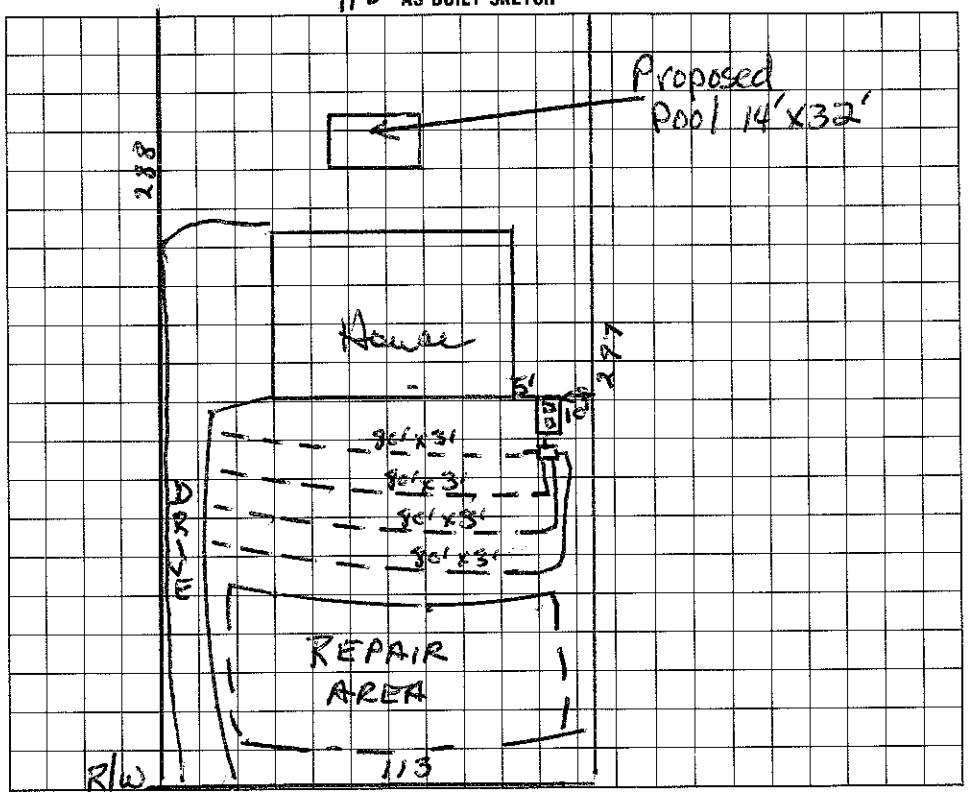

I understand that this permit can be suspended or revoked if any false information is supplied toward securing the permit/any unauthorized changes are made to the site/any unauthorized changes are made in the installation of the system. Improvement Permit is valid for 60 months from date of issuance.

Signed:

Improvement Permit by: date

Existing System Inspection by: date

Installed by: NORMANDY RD. LITTLES GRADING CO.

Certificate of Completion by: Wesley Sparks RS. date

Operation Permit by: date

HEALTH DEPT. COPY: WHITE INSPECTION COPY (FINAL): GREEN OWNER COPY (FINAL): YELLOW INSPECTION COPY (INITIAL): PINK OWNER COPY (INITIAL): GOLD