IREDELL COUNTY HEALTH DEPARTMENT

STATESVILLE 704-878-5305 MOORESVILLE 704-664-5281

IMPROVEMENT PERMIT / AUTHORIZATION TO CONSTRUCT / OPERATION PERMIT / EXISTING SYSTEM INSPECTION

E1512

PERMIT# 146564 PIN# 4638-33-3629V DATE 11/27/07

OWNER OR APPLICANT Donald Brzezinski PHONE: Business 704-902-3907 Home

ADDRESS 8624 New Oak Ln. Huntersville, NC. 28078

LOCATION 658 Normandy Rd. ; Mooresville, NC 28117

SUBDIVISION CL+T BLOCK / SECTION 11 LOT 428/144 LOT AREA .69 Ac SITE CLASS PS DESIGN FLOW 480 L.T.A.R. .3

Septic Tank: 1000 Gallons: STB 1012 Date 8-13-08

Pump Tank: 1000 Gallons: PT 17 Date 10-10-07

Pump Make: Goulds 1.5 Model WE1S12HM Serial No L0884835

Nitrification Field: No Fields 1 Square Feet 810 Linear Feet 270'

No Lines 3@90' Trench Width 2-3' Max Trench Bottom Depth 3'

[X] New System [ ] Repair [ ] Expansion System Type: I II III IV V VI

System Description: PressDosed - 16" PABRS

Repair System Description: Same Type

Maintenance Agreement Required: [X] Yes [ ] No

[X] House/Mod. Home [ ] Mobile Home [ ] Business [ ] Other

No. Bedrooms 4 No. Persons No. Employees


Water Supply: [X] Individual [ ] Public [ ] Community

Gravel Depth No [ ] Gravity [X] Pressure [ ] Slab [ ] Crawl Space [X] Basement w/plumbing [ ] Basement wo/plumbing

Comments/Conditions: (1) ABANDON WELL CLOSEST TO HOUSE (2) NEW WELL 10' FROM RPL AND 50' FROM 760' CONTOUR LINE (3) CENTRAL VALVE BOX (4) 3/16" HOLES - 1 PER PANEL TURNED UP (5) 2' MIN. PRESSURE HEAD REQUIRED AT DRAINLINES

(1" = 50')

INITIAL SITE SKETCH

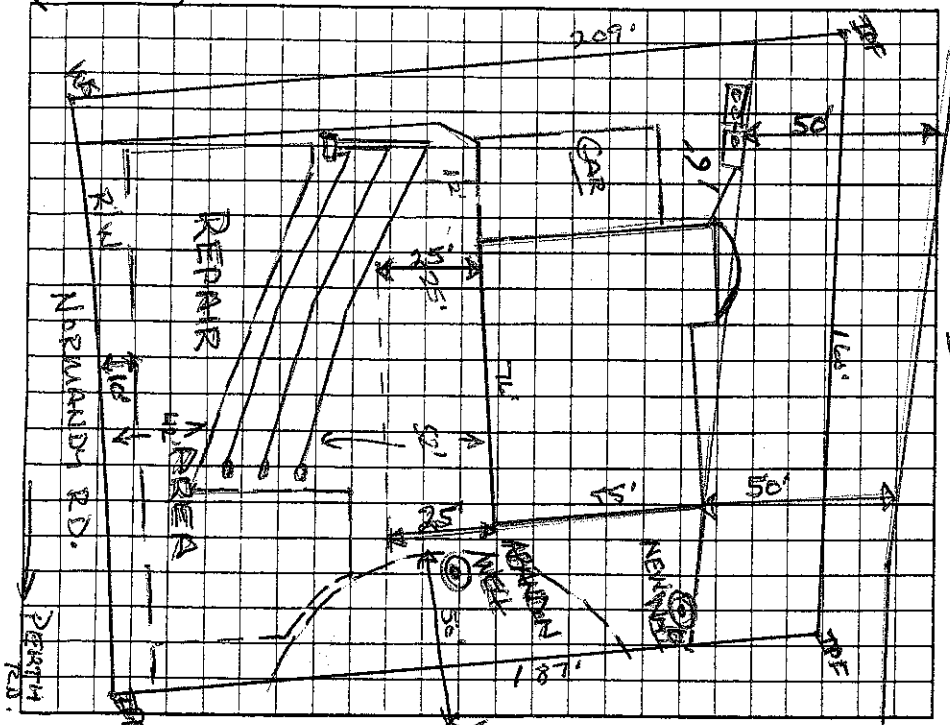

Comments/Conditions: Lines, Tanks, Pump & pressure & valve Box checked 3/19/09 AC Electrical & Maintenance agreement 3/27/09 AC

AS BUILT SKETCH

3/30/09 GW-35 well abandonment rec'd See abandonment permit. AC.

Proof of well grout dated 6/21/08 GW-1 attached to Health Dept copy. AC.

	Date	Initials
Drain Lines Checked	3/19/09	AC
Tanks Checked	3/19/09	AC
Pressure Manifold or Valve Box Checked	3/19/09	AC
Pressure Head Set	3/19/09	AC
Electrical Checked	3/30/09	AC
Floats Set	3/19/09	AC
Alarm Checked	3/30/09	AC
Maintenance Contract (Y) / N	3/27/09	AC

~~Need well Abandonment~~ 3/19/09 AC Rec'd 3/30/09

Permit can be suspended or revoked if any false information is supplied toward securing the permit/any unauthorized changes are made to the site/any unauthorized changes are made in the installation of the system. Improvement Permit with plat valid without expiration [ ] Improvement Permit with site plan valid for sixty months [ ] Authorization to Construct is valid for a period equal to that of Improvement Permit – not to exceed sixty months.

Signed: [signature] date 11/27/07

Improvement Permit by: Wesley Sparks R.S. date 11/27/07

Authorization to Construct by: Wesley Sparks R.S. date 11/27/07

Installed by: Tommy Frye

Operation Permit by: Anthony Coker, Jr. R.S. date 3/30/09

Existing System Inspection by: date

HEALTH DEPT. COPY: WHITE OWNER COPY (FINAL): YELLOW OWNER COPY (INITIAL): PINK