IREDELL COUNTY HEALTH DEPARTMENT

STATESVILLE 704-878-5305 MOORESVILLE 704-664-5281

280.00 Paid 4:00

IMPROVEMENT PERMIT / AUTHORIZATION TO CONSTRUCT / OPERATION PERMIT / EXISTING SYSTEM INSPECTION

PERMIT# 119871 PIN# 4638 33 4506 DATE 5/3/04

OWNER OR CONTRACTOR Jeff Arnold PHONE: Business Home

ADDRESS 652 Normandy Rd, Mooresville, NC. 28117

LOCATION 652 Normandy Rd on (R) past McNeirn Ln.

SUBDIVISION CAT BLOCK / SECTION 11 LOT 143 LOT AREA 1.8 Well SITE CLASS PS DESIGN FLOW 600 L.T.A.R. .3

Septic Tank: 1500 Gallons; STB 336 Date 2/21/05 1869

Pump Tank: Gallons; PT Date

Pump Make: Model Serial No.

Nitrification Field: No Fields 1 Square Feet 710 Linear Feet 355

No Lines 8 Trench Width 2-3' Max Trench Bottom Depth 3' Gravel Depth NA

☐ New System ☐ Repair System Type: I, II, III, IV, V, VI

System Description: GRAVITY 16" PIPES

Repair System Description: < 1983 N/A

Maintenance Agreement Required: ☐ Yes ☒ No

☒ House/Mod. Home No. Bedrooms 5

☐ Mobile Home No. Bathrooms 4.5

☐ Business No. Employees


☐ Other

☐ Slab ☐ Crawl Space ☒ Basement w/plumbing ☐ Basement wo/plumbing

Water Supply: ☒ Individual ☐ Public ☐ Community


Comments:/Conditions: 2' = 8' on centers / 3' on 9' Centers

INITIAL SITE SKETCH (1"=30')

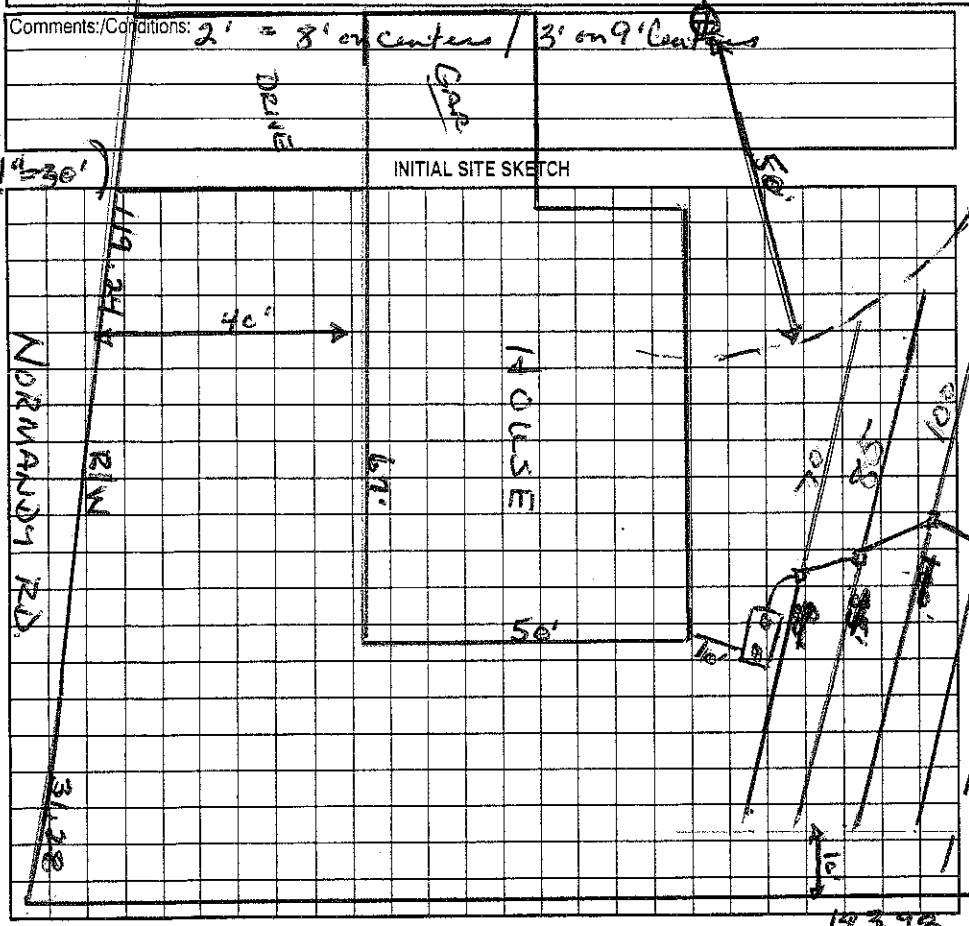

Comments:/Conditions:

AS BUILT SKETCH

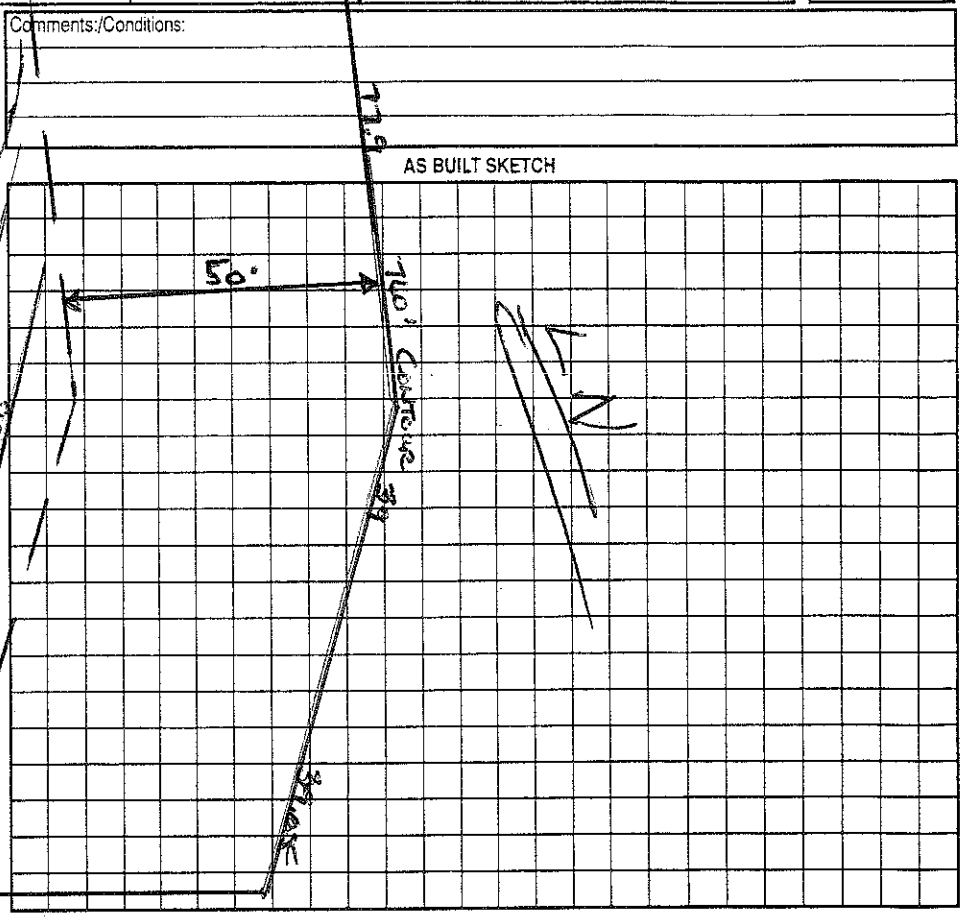

Permit can be suspended or revoked if any false information is supplied toward securing the permit/any unauthorized changes are made to the site/any unauthorized changes are made in the installation of the system. Improvement Permit with plat valid without expiration. Improvement Permit with site plan valid for sixty months. Authorization to Construct is valid for a period equal to that of Improvement Permit – not to exceed sixty months.

Signed: X date 6/3/04

Improvement Permit by: Wesley Sparks RS. date 5/3/04

Authorization to Construct by: Wesley Sparks RS. date 5/3/04

Installed by: Dwight Avery Septic

Operation Permit by: RS date 4/22/05

Existing System Inspection by: date

HEALTH DEPT. COPY: WHITE OWNER COPY (FINAL): YELLOW OWNER COPY (INITIAL): PINK