4638335259

IREDELL COUNTY HEALTH DEPARTMENT

STATESVILLE 704-878-5305 MOORESVILLE 704-664-5281

IMPROVEMENT PERMIT / CERTIFICATE OF COMPLETION / OPERATION PERMIT / EXISTING SYSTEM INSPECTION

PROPERTY DESCRIPTION NO. 22467 DATE 12/19/95 TAX MAP NO. 2P 4A 141 Watershed: [X] Yes [ ] No

OWNER OR CONTRACTOR Daryl Dean PHONE: Business Home 704-631-7235

ADDRESS 642 Normandy Rd. Mooresville, NC. 28115

LOCATION on (R) before cul de sac at mailbox #642

SUBDIVISION CL&T BLOCK / SECTION 11 LOT 141 LOT AREA Existing System SITE CLASS. PS DESIGN FLOW 240 L.T.A.R.

Septic Tank: Existing Gallons; STB Date

Pump Tank: Gallons; PT Date

Pump Make: Model Serial No.

Nitrification Field: No Fields Square Feet Linear Feet

No Lines Trench Width Existing Max Trench Bottom Depth Gravel Depth

[ ] New System [ ] Repair System Type: I, (II), III, IV, V, VI

System Description: Existing System

Repair System Description:

Maintenance Agreement Required: [ ] Yes [X] No

[ ] House/Mod. Home No. Bedrooms 2

[X] Mobile Home No. Bathrooms 2

[ ] Business No. Employees

[ ] Other

[ ] Slab [ ] Crawl Space [ ] Basement w/plumbing [ ] Basement wo/plumbing


Water Supply: [X] Individual [ ] Community [ ] Public

Comments:

L. NORMAN

760 CONTOUR

INITIAL SITE SKETCH

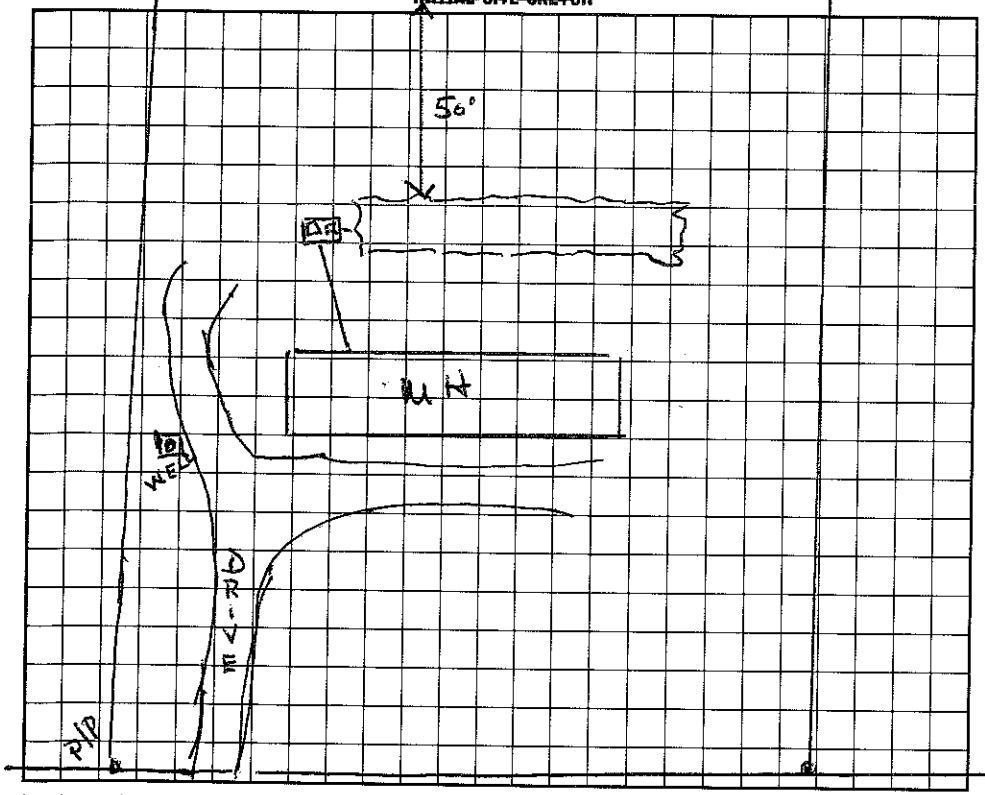

Comments:

AS BUILT SKETCH

I understand that this permit can be suspended or revoked if any false information is supplied toward securing the permit/any unauthorized changes are made to the site/any unauthorized changes are made in the installation of the system.

NORMANDY RD.

Signed:

Improvement Permit by: date

Existing System Inspection by: date

Installed by: Existing System

Certificate of Completion by: Wesley Sparks R.S. date 12/19/95

Operation Permit by: Wesley Sparks R.S. date 12/19/95

HEALTH DEPT. COPY: WHITE INSPECTION COPY (FINAL): GREEN OWNER COPY (FINAL): YELLOW INSPECTION COPY (INITIAL): PINK OWNER COPY (INITIAL): GOLD