2:30

IREDELL COUNTY HEALTH DEPARTMENT

STATESVILLE 704-878-5305 MOORESVILLE 704-664-5281

IMPROVEMENT PERMIT / AUTHORIZATION TO CONSTRUCT / OPERATION PERMIT / EXISTING SYSTEM INSPECTION

PERMIT# Repair PIN# 4638-34-0699 DATE

OWNER OR APPLICANT Paul Kelly PHONE: Business 704-799-2250 Home 704-664-7592

ADDRESS 146 Keenan Dr. Mooresville NC 28117

LOCATION 150 w. TR Perth, TL Normandy, TR Keenan, 2nd from the end

SUBDIVISION CL+T BLOCK / SECTION 11 LOT 104 LOT AREA SITE CLASS. PS DESIGN FLOW 360 L.T.A.R.

Septic Tank: 1000 Gallons; STB 7-15-08 Date 338
Pump Tank: 1000 Gallons; PT 6-26-08 Date 27
Pump Make: WE0312 Model Goulds Serial No. 1/3hp
Nitrification Field: No Fields 1 Square Feet 600' Linear Feet 200'
No Lines 5@40' Trench Width 24" Max Trench Bottom Depth 36" Gravel Depth — ☐ Gravity ☒ Pressure

☐ New System ☒ Repair ☐ Expansion System Type: I II III (IV) V VI
System Description: E
Repair System Description: LP PPBPS
Maintenance Agreement Required: ☒ Yes ☐ No

☒ House/Mod. Home No. Bedrooms 3
☐ Mobile Home No. Persons
☐ Business No. Employees
☐ Other


Water Supply: ☒ Individual ☐ Public ☐ Community

☐ Slab ☐ Crawl Space ☒ Basement w/plumbing ☐ Basement wo/plumbing

Comments/Conditions: In line filter must be used in pump tank/Keep drain lines min 10' off prop line + CVB + supply lines min 5' from prop lines/Keep line from pump tank to CVB 24" to stay out of old bed system

Comments/Conditions: Set pressure head @ 2'

INITIAL SITE SKETCH

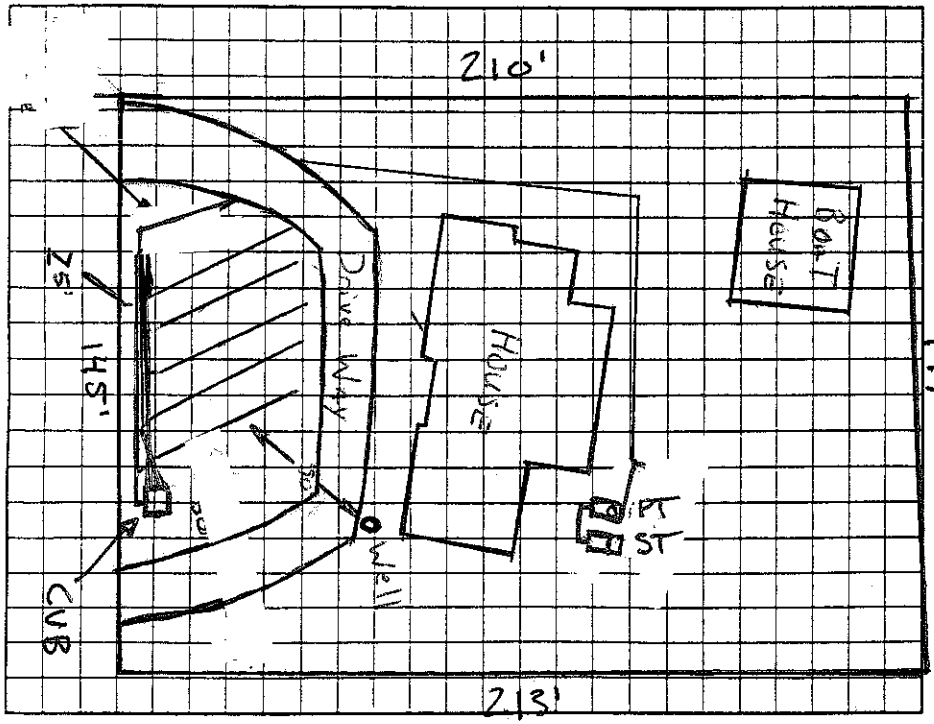

AS BUILT SKETCH

1) Installed 5 lines 40' long
2) Installed new tanks
3) Unhooked old tank from old bed system

Permit can be suspended or revoked if any false information is supplied toward securing the permit/any unauthorized changes are made to the site/any unauthorized changes are made in the installation of the system. Improvement Permit with plat valid without expiration ☐ Improvement Permit with site plan valid for sixty months ☒ Authorization to Construct is valid for a period equal to that of Improvement Permit – not to exceed sixty months.

Signed: Paul D. Kelly date

Improvement Permit by: J-Allig date 3-12-08

Authorization to Construct by: J-Allig date 6-18-08

Installed by: R+H

Operation Permit by: J-Allig date 10-27-08

Existing System Inspection by: date

HEALTH DEPT. COPY: WHITE OWNER COPY (FINAL): YELLOW OWNER COPY (INITIAL): PINK