IREDELL COUNTY HEALTH DEPARTMENT

STATESVILLE 704-878-5305 COPY MOORESVILLE 704-664-5281

IMPROVEMENT PERMIT / AUTHORIZATION TO CONSTRUCT / OPERATION PERMIT / EXISTING SYSTEM INSPECTION

PERMIT # REPAIR PIN # 4638-34-1799 DATE 3-11-11

OWNER or APPLICANT CARL STEWART PHONE: Business 704-202-9889 Home:

OWNER or APPLICANT ADDRESS MARK JACKSON

LOCATION / DIRECTIONS PERTH, NORMANDY, KEENAN, 144

SUBDIVISION CLET BLOCK / SECTION 11 LOT # 103 LOT AREA .727AC DESIGN FLOW 360 L.T.A.R.

Septic Tank 1050 Gallons: STB 3975L Date INELIGRATER

Pump Tank ____ Gallons: P T Date ____

Pump Make ____ Model ____ Serial # ____

Nitrification Field No Fields ____ No Lines EXIST LAG Linear Feet

Trench Width ____ Max. Trench Bottom Depth ____ Gravel Depth ____

☐ New System ☒ Repair ☐ Expansion System Type I (II) III IV V VI

System Description: REPLACE TANK

Repair System Description: ____

Maintenance Agreement Required ☐ YES ☐ NO

☐ GRAVITY ☐ PRESSURE

☒ Residence No. Bedrooms 3

☐ Business No. Persons ____

☐ Other No. Employees ____

☐ Slab ☒ Crawl Space


☐ Basement w/plumbing ☐ Basement w/o plumbing

Water Supply: ☒ Private ☐ Public ☐ Community


Comments / Conditions

Comments / Conditions

INITIAL SITE SKETCH

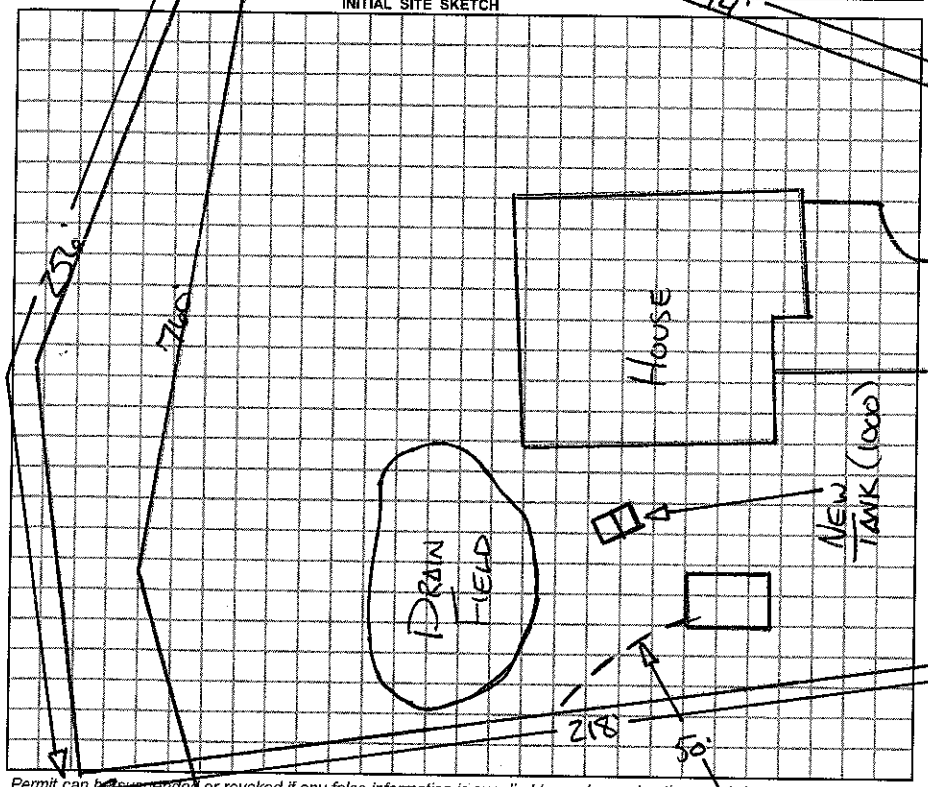

AS BUILT SKETCH

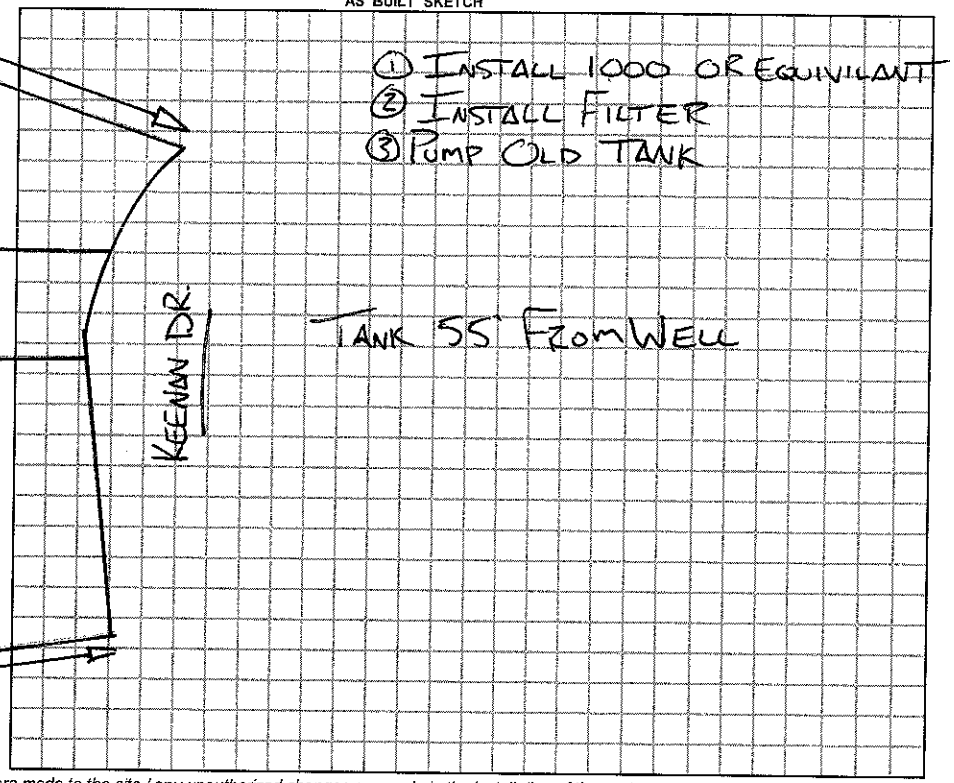

Permit can be suspended or revoked if any false information is supplied toward securing the permit / any unauthorized changes are made to the site / any unauthorized changes are made in the installation of the system.

☐ *IMPROVEMENT PERMIT w / plat valid without expiration.* ☐ *IMPROVEMENT PERMIT w / site plan valid for 60 mos.* ☐ *AUTHORIZATION TO CONSTRUCT valid for period equal to IMPROVEMENT PERMIT-not to exceed 60 mo.*

Owner / Applicant Signature: ____ Date ____

Improvement Permit by: BA Ogg REHS Date 3-11-11

Authorzation to Construct by: BA Ogg REHS Date 3-11-11

YOU SHOULD CONTACT A LOCATOR SERVICE PRIOR TO ANY EXCAVATION.

Installed by: S&S

Operation Permit by: BA Ogg REHS Date: 3-11-11

Existing System Inspected by: ____ Date: ____

WHITE COPY Environmental Health YELLOW COPY (Final) Owner / Applicant PINK COPY (Initial) Owner / Applicant