IREDELL COUNTY HEALTH DEPARTMENT

STATESVILLE 704-878-5305 MOORESVILLE 704-664-5281

IMPROVEMENT PERMIT / AUTHORIZATION TO CONSTRUCT / OPERATION PERMIT / EXISTING SYSTEM INSPECTION

PERMIT # REPAIR PIN # 4638-34-1799 DATE 3-11-11

OWNER or APPLICANT CARL STEWART PHONE: Business 704-202-9889 Home:

OWNER or APPLICANT ADDRESS /MARK JACKSON

LOCATION / DIRECTIONS PERTH, NORMANDY, KEENAN, 144

SUBDIVISION CLT BLOCK / SECTION 11 LOT # 103 LOT AREA .727AC DESIGN FLOW 360 L.T.A.R.

Septic Tank 1050 Gallons: STB 3975L Date INFILTRATER

Pump Tank Gallons: P T Date

Pump Make Model Serial #

Nitrification Field No Fields No Lines Linear Feet EXISTING

Trench Width Max. Trench Bottom Depth Gravel Depth

☐ New System ☒ Repair ☐ Expansion System Type I (II) III IV V VI

System Description: REPLACE TANK

Repair System Description:

Maintenance Agreement Required ☐ YES ☐ NO

☐ GRAVITY ☐ PRESSURE

☒ Residence No. Bedrooms 3

☐ Business No. Persons

☐ Other No. Employees

☐ Slab ☒ Crawl Space


☐ Basement w/plumbing ☐ Basement w/o plumbing

Water Supply: ☒ Private ☐ Public ☐ Community


Comments / Conditions

Comments / Conditions

INITIAL SITE SKETCH

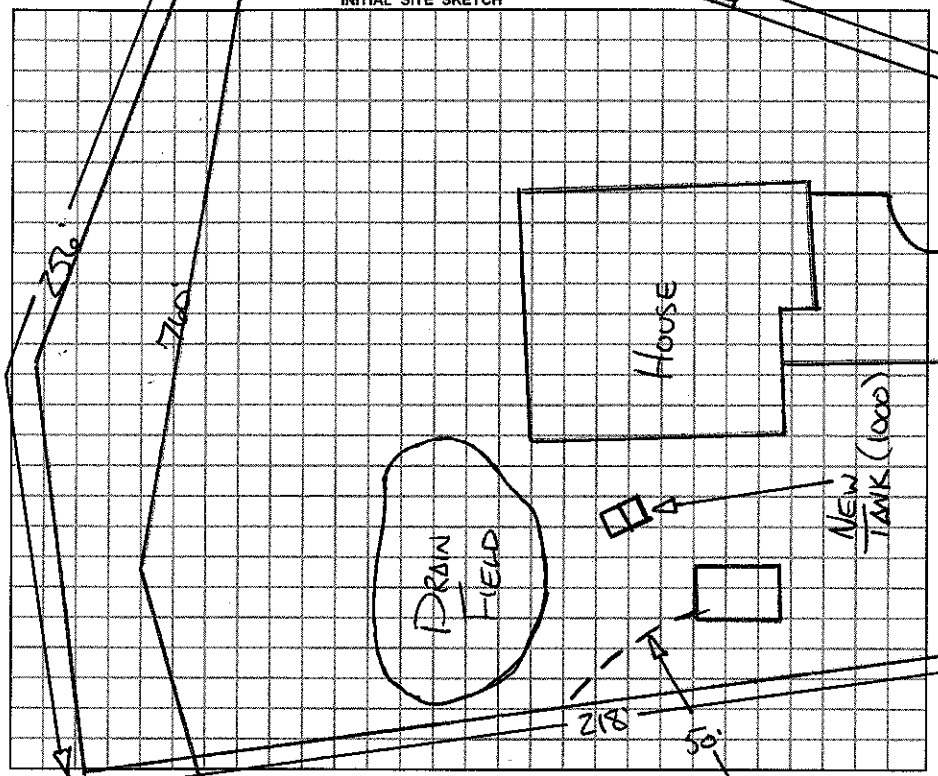

AS BUILT SKETCH

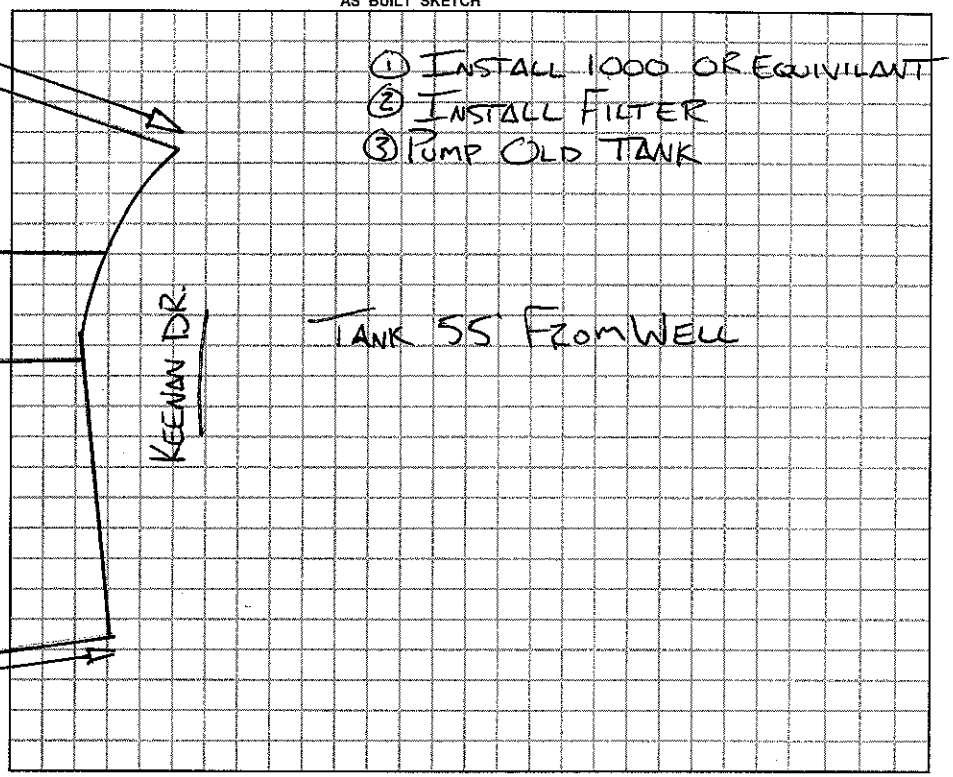

Permit can be suspended or revoked if any false information is supplied toward securing the permit / any unauthorized changes are made to the site / any unauthorized changes are made in the installation of the system.

☐ *IMPROVEMENT PERMIT w / plat valid without expiration.* ☐ *IMPROVEMENT PERMIT w / site plan valid for 60 mos.* ☐ *AUTHORIZATION TO CONSTRUCT valid for period equal to IMPROVEMENT PERMIT-not to exceed 60 mo.*

Owner / Applicant Signature Date

Improvement Permit by: REHS Date 3-11-11

Authorzation to Construct by: REHS Date 3-11-11

YOU SHOULD CONTACT A LOCATOR SERVICE PRIOR TO ANY EXCAVATION.

Installed by: S&S

Operation Permit by: REHS Date: 3-11-11

Existing System Inspected by: Date:

WHITE COPY Environmental Health YELLOW COPY (Final) Owner / Applicant PINK COPY (Initial) Owner / Applicant