...CDELL COUNTY HEALTH DEPARTMENT

STATESVILLE 704-878-5305 450.00 Paid MOORESVILLE 704-664-5281

IMPROVEMENT PERMIT / AUTHORIZATION TO CONSTRUCT / OPERATION PERMIT / EXISTING SYSTEM INSPECTION

PERMIT# 094295 PIN# 4638343836 DK Construction 622-0912 DATE 4/26/2001

OWNER OR CONTRACTOR Joseph & Gayle Dobson PHONE: Business 568-3691 Home 849-0073

ADDRESS 350 Abbotsford Dr Charlotte NC 28270

LOCATION Perth Rd TL Normandy TR Keenan at end

SUBDIVISION C & T BLOCK / SECTION 11 LOT 102 LOT AREA .74 Acre SITE CLASS. V DESIGN FLOW 480gpd L.T.A.R. .25 (to 40%)

Septic Tank: 1000 Gallons; STB 794 Date 11-20-01
Pump Tank: 1000 Gallons; PT 283 Date 1-4-2000
Pump Make: Goulds Model WE0511H Serial No 10-16-01 10153923
Nitrification Field: No Fields 1 Square Feet 640' Linear Feet 350
No Lines 5 Trench Width 24"-36" Max Trench Bottom Depth 30"

☒ New System ☐ Repair System Type: I, II, III, IV, V, VI
System Description: 4" Panel Block
Repair System Description: (Partial) Lot deeded prior to 1983
Maintenance Agreement Required: ☒ Yes ☐ No
Gravel Depth N/A


☒ House/Mod. Home No. Bedrooms 4
☐ Mobile Home No. Bathrooms 3.5
☐ Business No. Employees
☐ Other
☐ Slab ☐ Crawl Space ☐ Basement w/plumbing ☐ Basement wo/plumbing

Water Supply: ☒ Individual ☐ Public ☐ Community

Comments:/Conditions: ☆ Very Tight Site, must be very careful with setbacks. Keep Septic System 10' from PL, 50' from lake & 50' from any well. Sleeve Supply line under driveway.


Comments:/Conditions: Old existing well must be "properly abandoned" in compliance with DHHR rules. Do Not grade down Septic areas — Very Shallow soils @ 40"-42"

INITIAL SITE SKETCH Scale 1:60

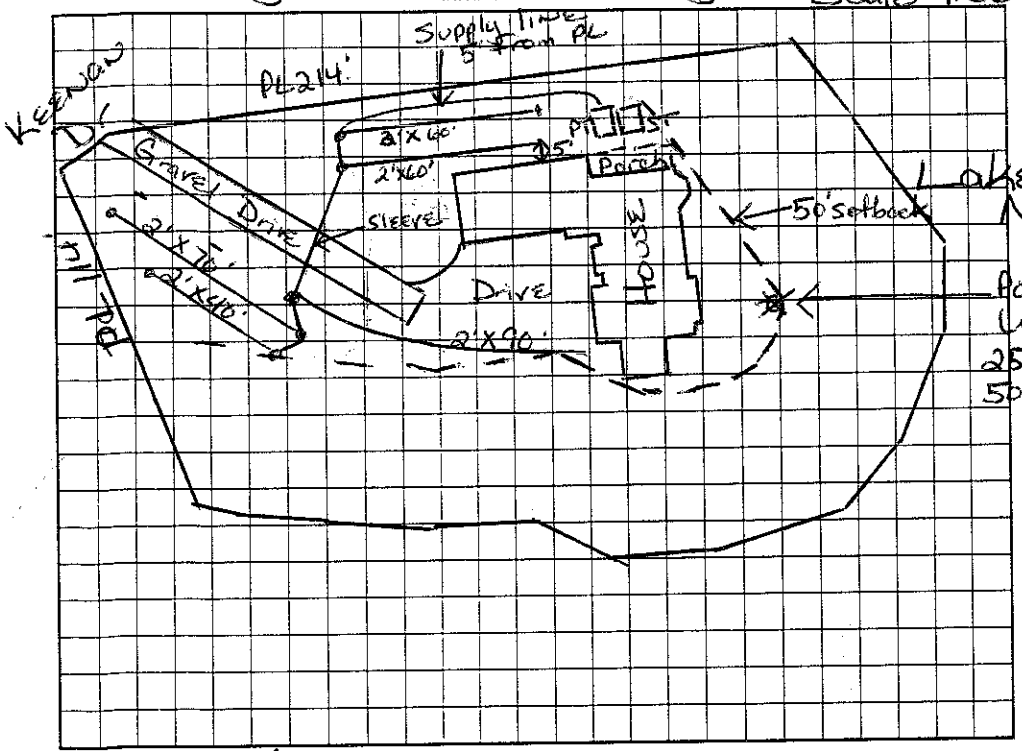

AS BUILT SKETCH 5/32" hole

Tanks, lines & pressure checked 2/26/02

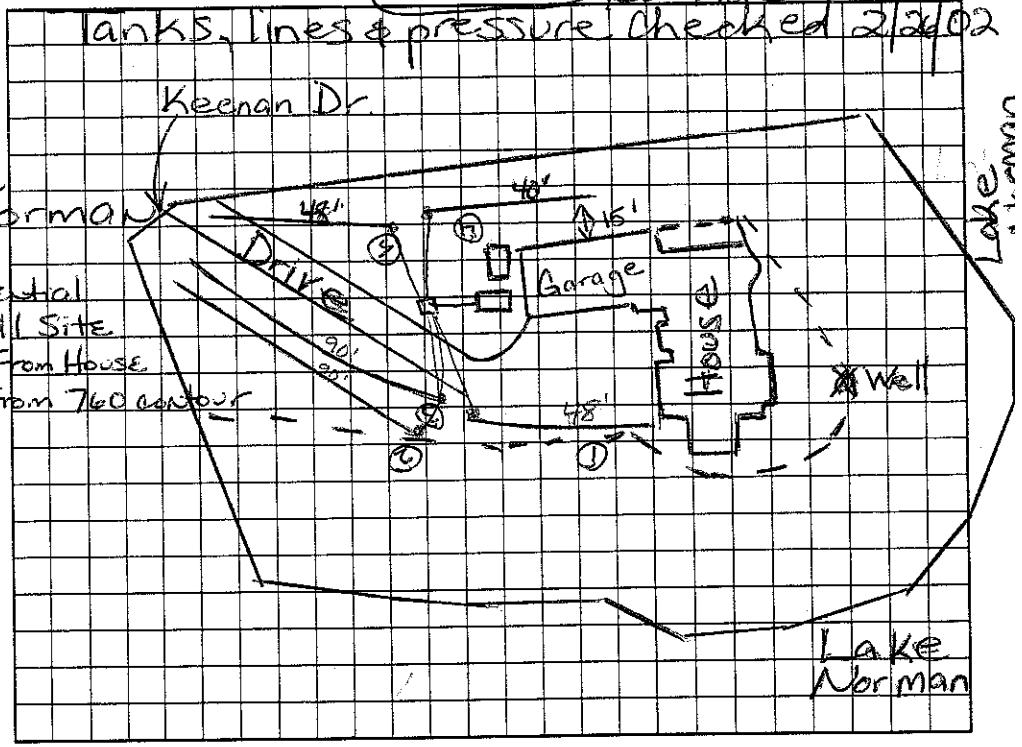

Permit can be suspended or revoked if any false information is supplied toward securing the permit/any unauthorized changes are made to the site/any unauthorized changes are made in the installation of the system. Improvement Permit with plat valid without expiration. Improvement Permit with site plan valid for sixty months. Authorization to Construct is valid for a period equal to that of Improvement Permit – not to exceed sixty months.

Signed: [signature] date 5/9/01 Installed by: C. Wayne Dobson RS

Improvement Permit by: Maria H. H. Dobson RS. date 4/26/01 Operation Permit by: Maria H. H. Dobson date 3/27/02

Authorization to Construct by: Maria H. H. Dobson RS. date 4/26/01 Existing System Inspection by: date

HEALTH DEPT. COPY: WHITE OWNER COPY (FINAL): YELLOW OWNER COPY (INITIAL): PINK