CLT #97 Sec. II

IREDELL COUNTY HEALTH DEPARTMENT

STATESVILLE 704-878-5305 MOORESVILLE 704-664-5281

IMPROVEMENT PERMIT / AUTHORIZATION TO CONSTRUCT / OPERATION PERMIT / EXISTING SYSTEM INSPECTION

11,000

PERMIT# 140793 PIN# 4638347991 DATE 3/12/07

OWNER OR APPLICANT Ponce Keller PHONE: Business _____ Home _____

ADDRESS 9434 Stanbridge Ln Huntersville NC 28078 370 Normandy Rd

LOCATION Perth Rd (N), Left on Normandy, approx 3/4 to 1 mile on Right

SUBDIVISION CL+T BLOCK / SECTION 11 LOT 97 LOT AREA .84 Acre SITE CLASS. PS DESIGN FLOW 480 L.T.A.R. .3gpd/ft²

Septic Tank: 1000 Gallons: STB 821 Date 12-2-07 ☑ New System ☐ Repair ☐ Expansion System Type: I II III IV V VI ☑ House/Mod. Home No. Bedrooms 4 Water Supply: ☑ Individual

Pump Tank: 1000 Gallons: PT 740 Date 10-16-07 System Description: LP Rnel Sick ☐ Mobile Home No. Persons 8 ☐ Public ☐ Community

Pump Make Zoeller Model N-152B Serial No. _____ Repair System Description: Same ☐ Business No. Employees _____

Nitrification Field: No Fields 1 Square Feet 810 Linear Feet 270 Maintenance Agreement Required: ☑ Yes ☐ No ☐ Other _____

No Lines 4@68' Trench Width 24"/36" Max Trench Bottom Depth 36" Gravel Depth N/A ☐ Gravity ☒ Pressure ☐ Slab ☒ Crawl Space ☐ Basement w/plumbing ☐ Basement wo/plumbing

.4 HP 115V

Comments:/Conditions: Minimum of 15' allowed between pool cut site, and any part of Septic System (i.e. tanks, lines, etc)

-4 Lines @ 68' each of T&J panel


Comments:/Conditions: Tanks, Lines, pressure check

Relayout 11-20-07 gm 1-25-08 gm


5/32 hole size

Red Poly10K

INITIAL SITE SKETCH

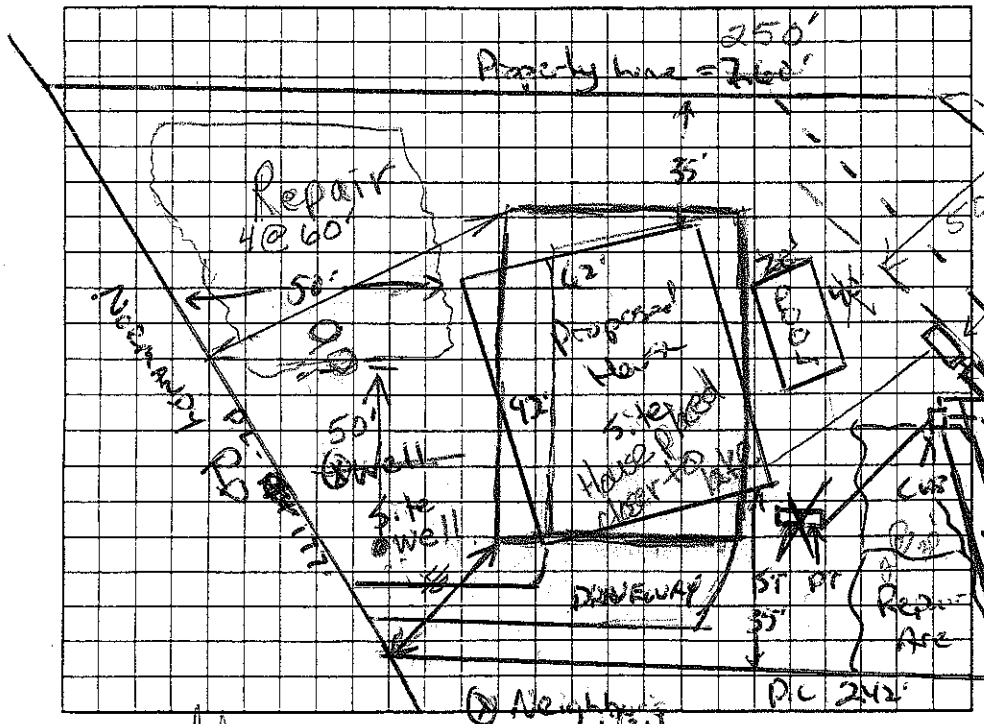

AS BUILT SKETCH

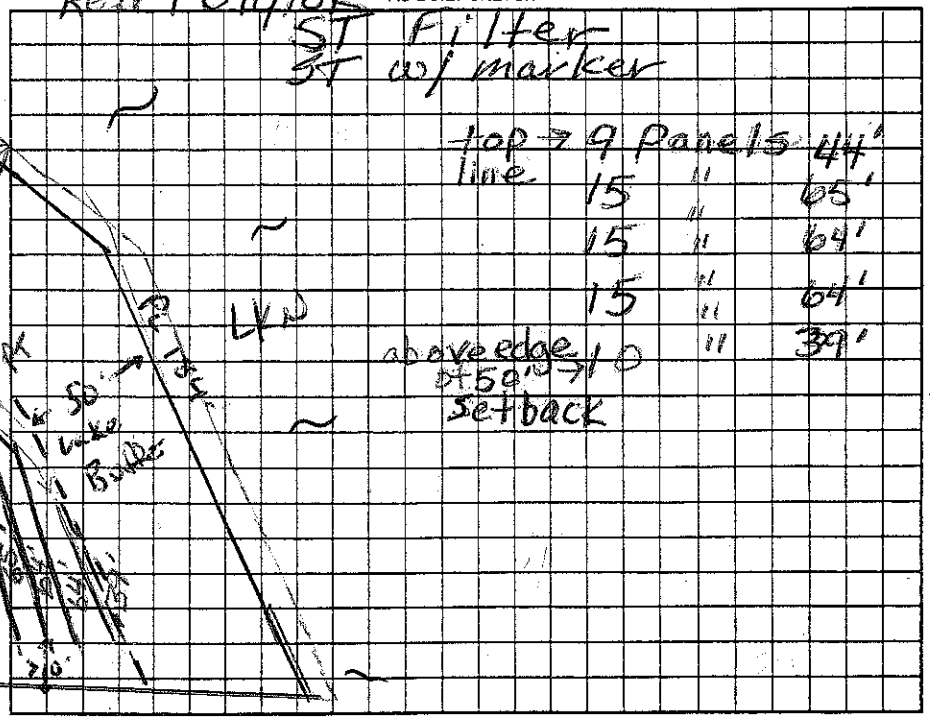

Permit can be suspended or revoked if any false information is supplied toward securing the permit/any unauthorized changes are made to the site/any unauthorized changes are made in the installation of the system. Improvement Permit with plat valid without expiration ☐ Improvement Permit with site plan valid for sixty months ☑ Authorization to Construct is valid for a period equal to that of Improvement Permit – not to exceed sixty months.

Signed: _____ date 3/13/07 Installed by: Dennis Willis Septic Level IV

Improvement Permit by: _____ date 3/13/07 Operation Permit by: Andy Melville date 3-19-08

Authorization to Construct by: _____ date 3/21/07 Existing System Inspection by: _____ date _____

HEALTH DEPT. COPY: WHITE OWNER COPY (FINAL): YELLOW OWNER COPY (INITIAL): PINK

704-435-5987 Bryson Willis 2nd contact 704-305 mobile