IREDELL COUNTY HEALTH DEPARTMENT

STATESVILLE 704-878-5305 MOORESVILLE 704-664-5281

IMPROVEMENT PERMIT / AUTHORIZATION TO CONSTRUCT / OPERATION PERMIT / EXISTING SYSTEM INSPECTION

DATE 9-26-2012

PERMIT # 174491 PIN # 4638357098

OWNER or APPLICANT Lisa McGee / Brad Russell PHONE: Business Brad 704 361-9707 Home:

OWNER or APPLICANT ADDRESS 142 Hidden Harbor Rd M'ville, NC 28117

LOCATION / DIRECTIONS Hwy 150 West TR Perth Rd TL Normandy on right #362

SUBDIVISION C L & T BLOCK / SECTION ~~Sec~~ II LOT # 96 LOT AREA .984C DESIGN FLOW 480gpd L.T.A.R. .3

Septic Tank 1000 Gallons: STB 794 Date 4-16-13

Pump Tank 1000 Gallons: PT 283 Date 8-25-13

Pump Make Goulds Model WE0312M Serial #

Nitrification Field No Fields 1 No Lines 4 Linear Feet 210 268

Trench Width min 24" Max. Trench Bottom Depth 36" Gravel Depth N/A

☒ New System ☐ Repair ☐ Expansion System Type I II III IV V VI

System Description: Pump-LP-Panel Block

Repair System Description: Same

Maintenance Agreement Required ☒ YES ☐ NO

☐ GRAVITY ☒ PRESSURE

☒ Residence No. Bedrooms 4 ☐ Business No. Persons ☐ Other No. Employees ☐ Slab ☐ Crawl Space ☒ Basement w/plumbing ☐ Basement w/o plumbing


Water Supply: ☒ Private ☐ Public ☐ Community

Comments / Conditions: ~~X~~ Note: Well must be "properly abandoned" prior to issue of Building Permit. Keep tanks 15ft from basement if flat side gradient. $AC.

Comments / Conditions: Divert Stormwater Away from Septic System. ~~XX~~ Must properly abandon well 11/4/13

INITIAL SITE SKETCH


Scale 1:50

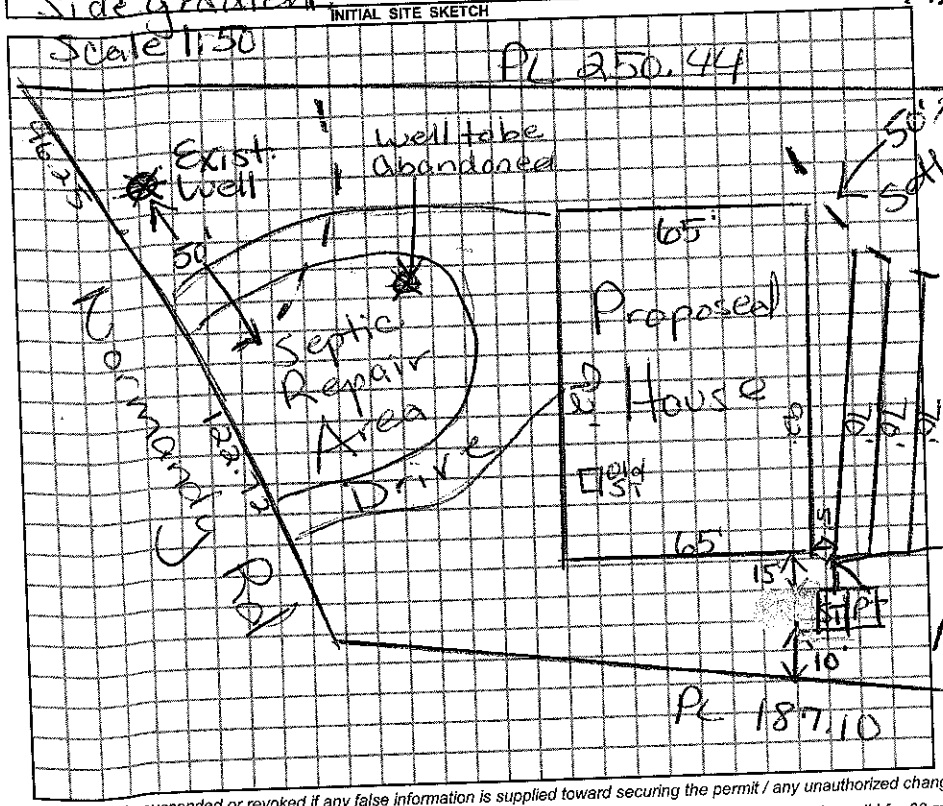

AS BUILT SKETCH

9/27/13 Checked all lines line lengths highest (by house)

75'
26
28
27
27
45
40' by lake

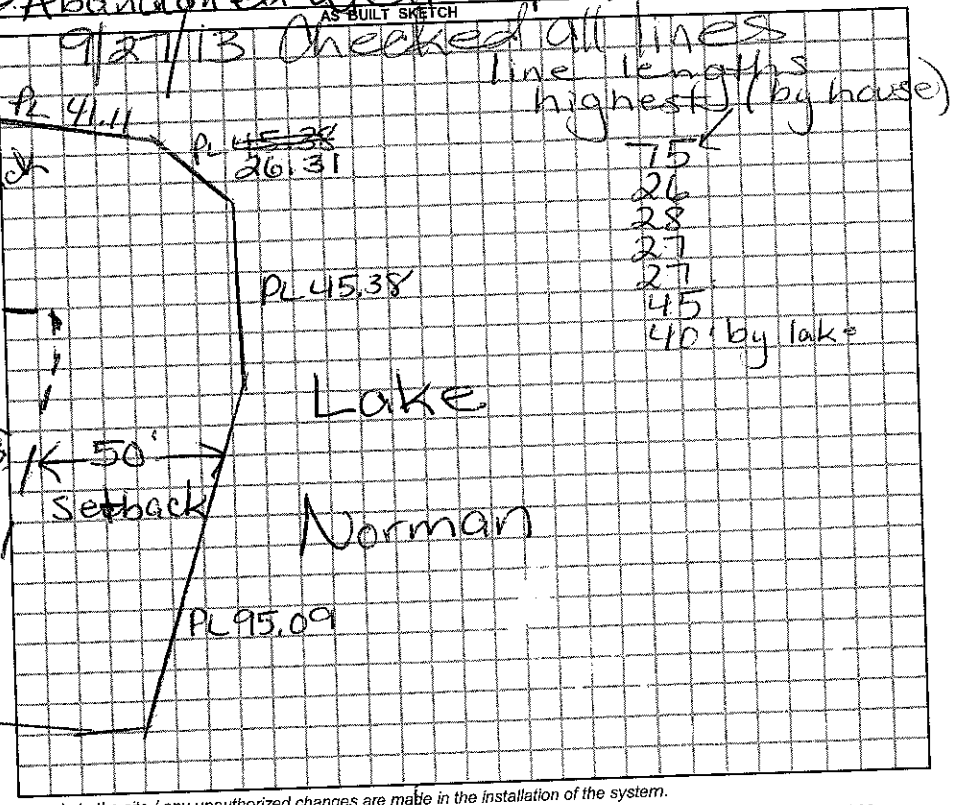

Permit can be suspended or revoked if any false information is supplied toward securing the permit / any unauthorized changes are made to the site / any unauthorized changes are made in the installation of the system.

☐ IMPROVEMENT PERMIT w / plat valid without expiration. ☐ IMPROVEMENT PERMIT w / site plan valid for 60 mos. ☐ AUTHORIZATION TO CONSTRUCT valid for period equal to IMPROVEMENT PERMIT-not to exceed 60 mo.

Owner / Applicant Signature: Date 1-22-13

Permit by: Date 9/26/12

to Construct by: Date 11/22/13

Installed by: R&H

Operation Permit by: Date: 2-7-14

Existing System Inspected by: Date:

SHOULD CONTACT A LOCATOR SERVICE PRIOR TO ANY EXCAVATION.

WHITE COPY Environmental Health YELLOW COPY (Final) Owner / Applicant PINK COPY (Initial) Owner / Applicant