IREDELL COUNTY HEALTH DEPARTMENT

STATESVILLE 704-878-5305 MOORESVILLE 704-664-5281

IMPROVEMENT PERMIT / AUTHORIZATION TO CONSTRUCT / OPERATION PERMIT / EXISTING SYSTEM INSPECTION

PERMIT # 155585 PIN # 4638380215 DATE 8-17-2010

OWNER or APPLICANT Matt Reavis PHONE: Business 880-8912 Home:

OWNER or APPLICANT ADDRESS 171 Lempster Dr NW Concord, NC 28027

LOCATION / DIRECTIONS Perth Rd N to Fernhill Rd to 2nd Kenway Lp on left

SUBDIVISION Fernleaf BLOCK / SECTION B LOT # 12 LOT AREA DESIGN FLOW 480gpd L.T.A.R. .3

Septic Tank 1000 Gallons: STB 825 Date 10-8-10 ☒ New System ☐ Repair ☐ Expansion System Type I II III IV V VI

Pump Tank 1000 Gallons: PT 302 Date 8-15-10 System Description: Pump-PM-25% Reduction

Pump Make Goulds Model WE03IM Serial # Repair System Description: Pump-LP-Panel Blk

Nitrification Field No Fields 1 No Lines 5 Linear Feet 400' Maintenance Agreement Required ☐ YES ☒ NO Not initially

Trench Width 36" Max. Trench Bottom Depth 36" Gravel Depth N/A ☐ GRAVITY ☒ PRESSURE

☒ Residence No. Bedrooms 4 ☐ Business No. Persons ☐ Other No. Employees ☐ Slab ☐ Crawl Space ☐ Basement w/plumbing ☐ Basement w/o plumbing


Water Supply: ☒ Private ☐ Public ☐ Community

Comments / Conditions: Bonus room must have arched entry

★ Keep 100Ft setback btw Well & Drainfield

Comments / Conditions: ★ Must keep pool "cut" at least 15' From ST/PT & Drainfield (including Repair area) Keep Supply line at least 10 Ft From Pool cut.

INITIAL SITE SKETCH

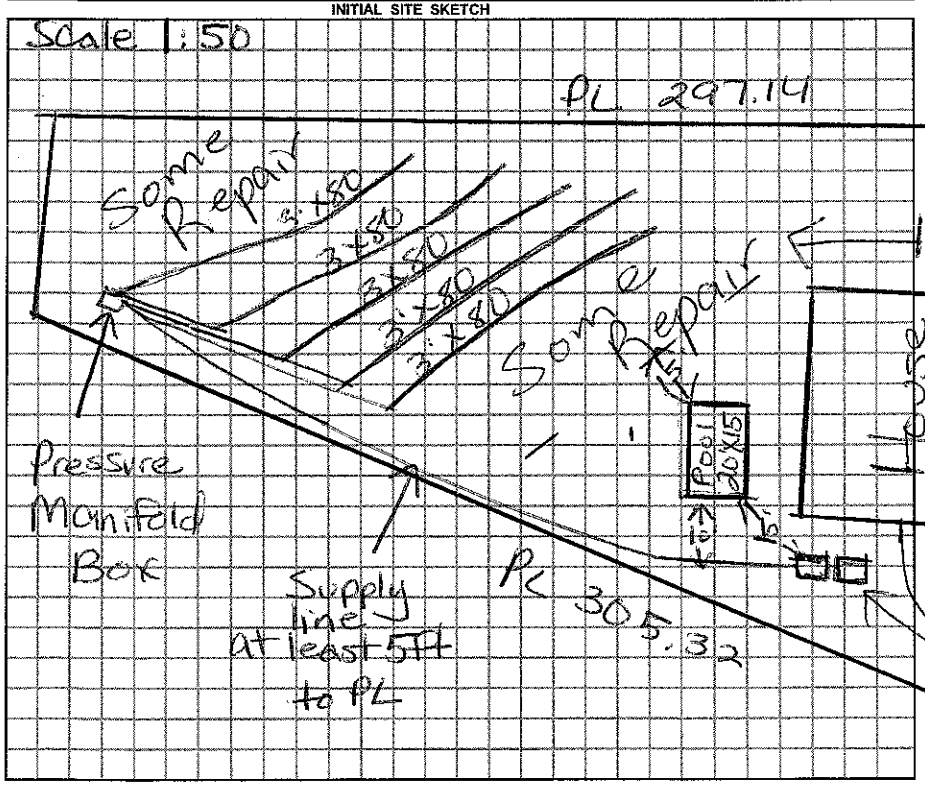

AS BUILT SKETCH

★ This permit replaces previous permit From 3/24/09

12/10/2010 checked lines tanks & Pres Man. Quick 4

Permit can be suspended or revoked if any false information is supplied toward securing the permit / any unauthorized changes are made to the site / any unauthorized changes are made in the installation of the system.

☐ *IMPROVEMENT PERMIT w / plat valid without expiration.* ☐ *IMPROVEMENT PERMIT w / site plan valid for 60 mos.* ☐ *AUTHORIZATION TO CONSTRUCT valid for period equal to IMPROVEMENT PERMIT-not to exceed 60 mo.*

Owner / Applicant Signature: Matt Reavis Date 8/24/10 Installed by: Wayne Gentry RS

Improvement Permit by: Maria H. Dobson REHS Date 8/18/2010 Operation Permit by: Maria H. Dobson Date: 2/24/11

Authorzation to Construct by: Maria H. Dobson Date 8/18/2010 Existing System Inspected by: Date:

YOU SHOULD CONTACT A LOCATOR SERVICE PRIOR TO ANY EXCAVATION.

WHITE COPY Environmental Health YELLOW COPY (Final) Owner / Applicant PINK COPY (Initial) Owner / Applicant

Matt Reavis ques 515.00

IREDELL COUNTY HEALTH DEPARTMENT

STATESVILLE 704-878-5305 MOORESVILLE 704-664-5281

IMPROVEMENT PERMIT / AUTHORIZATION TO CONSTRUCT / OPERATION PERMIT / EXISTING SYSTEM INSPECTION

PERMIT # 155585 PIN # 4638380215.000 DATE 3/24/09 Matt

OWNER or APPLICANT Woodbridge Partners LLC PHONE: Business 704 799-9770 Home: 704 701 7793

OWNER or APPLICANT ADDRESS PO Box 3608 Mooresville NC 28117

LOCATION / DIRECTIONS Perth Rd (N) TL Fernhill Rd. TL Kenway Lp on (R)

SUBDIVISION Fernleaf BLOCK / SECTION LOT # 12 LOT AREA .764 DESIGN FLOW 480 L.T.A.R. .3

Septic Tank 1000 Gallons: STB Date

Pump Tank 1000 Gallons: PT Date

Pump Make Model Serial #

Nitrification Field No Fields 1 No Lines 4 Linear Feet 267'

Trench Width 24" min Max. Trench Bottom Depth 36" Gravel Depth N/A

☑ New System ☐ Repair ☐ Expansion System Type I II III (IV) V VI

System Description: LP PPBPS

Repair System Description: Same

Maintenance Agreement Required ☑ YES ☐ NO

☐ GRAVITY ☑ PRESSURE

☑ Residence No. Bedrooms 4

☐ Business No. Persons

☐ Other No. Employees

☐ Slab ☑ Crawl Space

☐ Basement w/plumbing ☐ Basement w/o plumbing

Water Supply: ☑ Private ☐ Public ☐ Community

Comments / Conditions ↑ 8' off center

* Bonus room must have Arched entry
* Install approved in-line filter in pump tank

INITIAL SITE SKETCH

Plan by S&ME

Plat submitted - Non expiring IP.

Comments / Conditions Lot requires some shaping to remove old field terraces / knock down high spots to blend with low spots.

3/9/2010 Reviewed Floor plans & Site plan, in Compliance with Original permit

AS BUILT SKETCH

Permit can be suspended or revoked if any false information is supplied toward securing the permit / any unauthorized changes are made to the site / any unauthorized changes are made in the installation of the system.

☑ IMPROVEMENT PERMIT w / plat valid without expiration. ☑ ~~IMPROVEMENT PERMIT w / site plan valid for 60 mos.~~ ☐ AUTHORIZATION TO CONSTRUCT valid for period equal to IMPROVEMENT PERMIT-not to exceed 60 mo.

Owner / Applicant Signature: Kathleen Saunders Date 3/27/09

Improvement Permit by: Anthony Cokeley R.S. Date 3/24/09

Authorization to Construct by: Mark H Nelson REHS Date 3/9/2010

Installed by:

Operation Permit by: Date:

Existing System Inspected by: Date:

YOU SHOULD CONTACT A LOCATOR SERVICE PRIOR TO ANY EXCAVATION

WHITE COPY Environmental Health YELLOW COPY (Final) Owner / Applicant PINK COPY (Initial) Owner / Applicant