IREDELL COUNTY HEALTH DEPARTMENT

STATESVILLE 704-878-5305 MOORESVILLE 704-664-5281

IMPROVEMENT PERMIT / AUTHORIZATION TO CONSTRUCT / OPERATION PERMIT / EXISTING SYSTEM INSPECTION

PERMIT# 115255 PIN# 4763838684 John (Contractor) DATE 9-18-03

OWNER OR CONTRACTOR Jodi Kasempa & Michael Orr PHONE: Business 704 400-2917 Home

ADDRESS 574 Kenway Loop Mooresville, NC 28117

LOCATION Perth Rd North to Fern Hill TL Kenway Loop (2nd) ~ 1/4 mile on right

SUBDIVISION Clear BLOCK / SECTION 15 LOT 45 LOT AREA .74 Acres SITE CLASS. S5 DESIGN FLOW 360 gpd T.A.R.

Septic Tank: 1000 Gallons; STB Date

Pump Tank: Existing Gallons; PT Date

Pump Make: Model Serial No.

Nitrification Field: Existing No. Fields 1 Square Feet 900 Linear Feet 300

No. Lines 6 @ 50' Trench Width 36 Max Trench Bottom Depth 36" Gravel Depth N/A

☐ New System ☐ Repair System Type: I, II, III, IV, V, VI

System Description: Existing Gravity - 25% Reduction

Repair System Description:

Maintenance Agreement Required: ☐ Yes ☒ No

☒ House/Mod. Home No. Bedrooms 3

☐ Mobile Home No. Bathrooms 3

☐ Business No. Employees

☐ Other


☐ Slab ☒ Crawl Space ☐ Basement w/plumbing ☐ Basement wo/plumbing

Water Supply: ☒ Individual ☐ Public ☐ Community


Comments:/Conditions: Existing Septic System appears to be functioning okay at time of inspection.

Comments:/Conditions: Original permit attached Installed 2001 * Keep Addition at least 5' From Septic System @ 25' from well

INITIAL SITE SKETCH

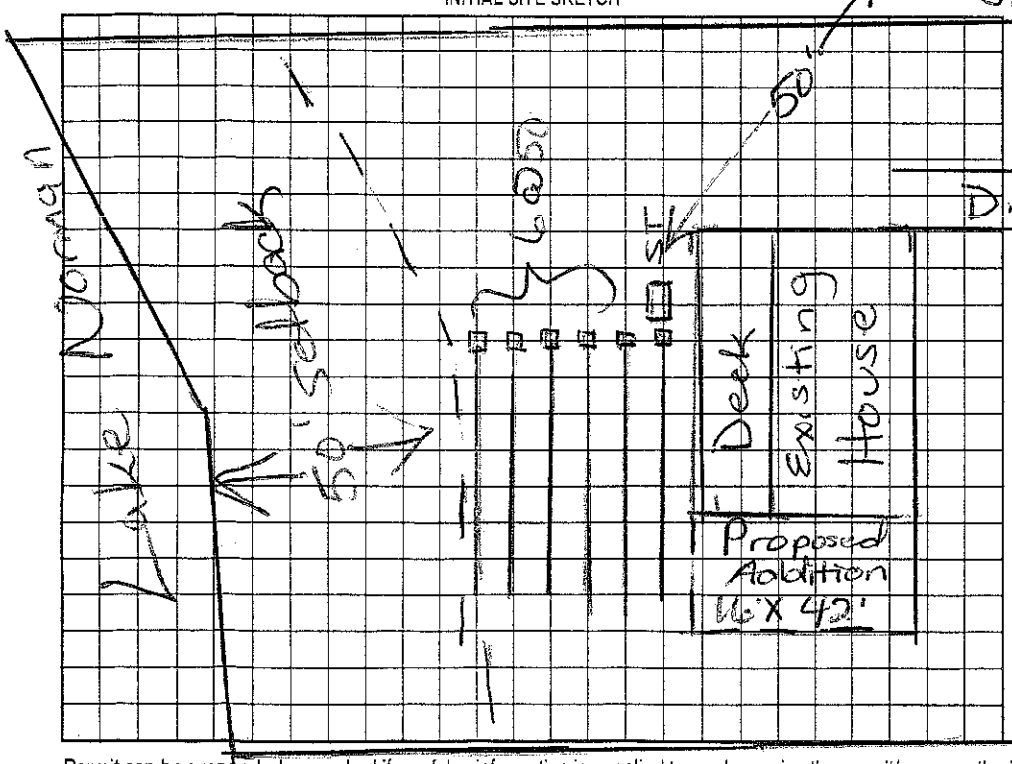

AS BUILT SKETCH

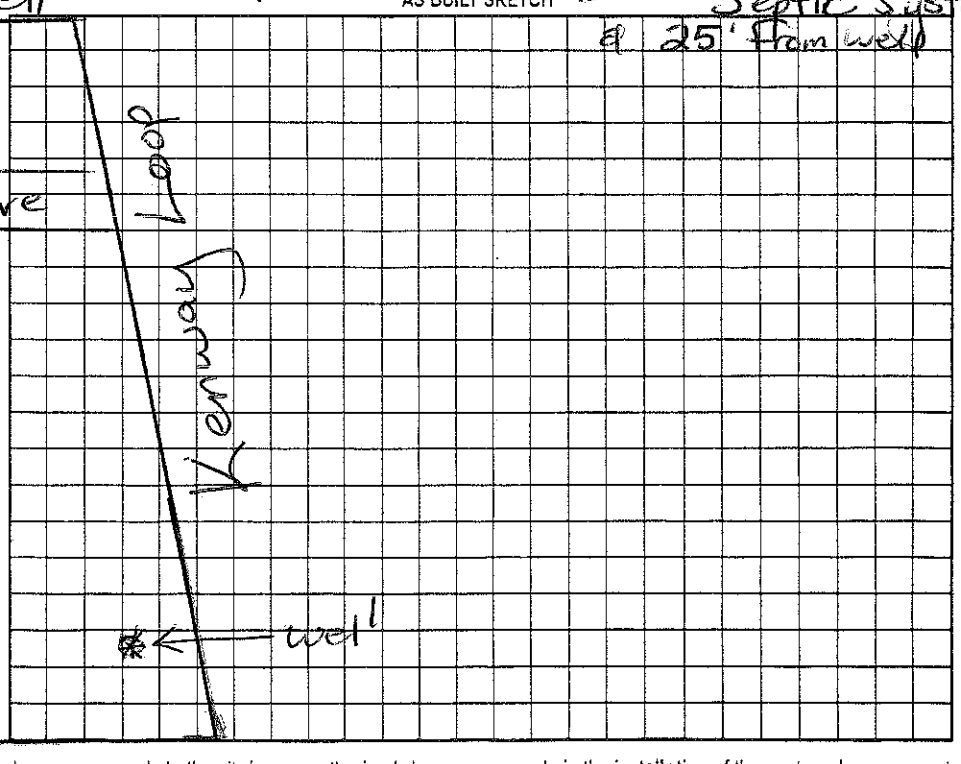

Permit can be suspended or revoked if any false information is supplied toward securing the permit/any unauthorized changes are made to the site/any unauthorized changes are made in the installation of the system. Improvement Permit with plat valid without expiration. Improvement Permit with site plan valid for sixty months. Authorization to Construct is valid for a period equal to that of Improvement Permit – not to exceed sixty months.

Signed: X Jodi T. Kasempa date 9-18-03 Installed by:

Improvement Permit by: date Operation Permit by: date

Authorization to Construct by: Maina H Dolan RS date 9/18/03 Existing System Inspection by: Maina H Dolan RS date 9/18/03

HEALTH DEPT. COPY: WHITE OWNER COPY (FINAL): YELLOW OWNER COPY (INITIAL): PINK