IREDELL COUNTY HEALTH DEPARTMENT

Statesville Phone TR 3-7271 Mooresville Phone NO 3-1271

PERMIT TO INSTALL SEPTIC TANK

Permit NO. _____ Permit Date 20 July 1965

Owner H. L. Ewing Address _____

Installed By Edwin L. Norwalk Address Troutman, N C


Location of Property Lake Norman Sec 15 Lot 44

Tank		Capacity		Length of Lines		Fixtures	
Block	(✓)	800	( )	150'	( )	No. of Baths	( )
Precast	( )	900	( )	175'	( )	Dishwasher	( )
		1000	(✓)	200'	( )	Garbage Grdr.	( )
		1100	( )	225'	(✓)	Auto-Washer	( )
		1200	( )	250'	( )	Other _____	
		Other _____		Other _____			

NOTIFY HEALTH DEPARTMENT AT LEAST EIGHT HOURS BEFORE TANK IS TO BE INSPECTED.

Final Inspection 20 July 1965 Approved (✓) Disapproved ( )

Remarks _____

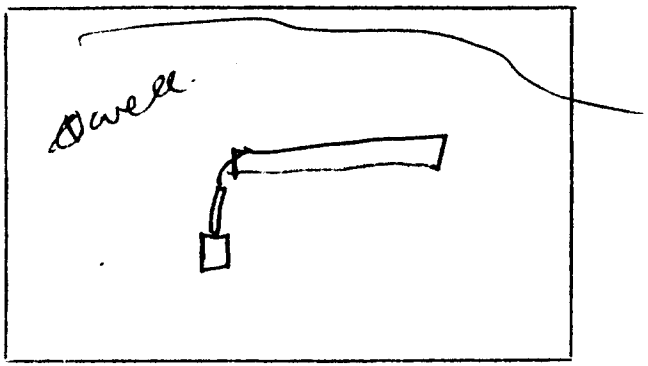

Sketch of Installation

Troy Scoggins RS

Sanitarian