IREDELL COUNTY HEALTH DEPARTMENT

STATESVILLE 704-878-5305 MOORESVILLE 704-664-5281

IMPROVEMENT PERMIT / AUTHORIZATION TO CONSTRUCT / OPERATION PERMIT / EXISTING SYSTEM INSPECTION

525

PERMIT# 118886 PIN# 4638-38-2048 DATE 3/10/04

OWNER OR CONTRACTOR Profitt Custom Homes PHONE: Business 704-201-7515 Home

ADDRESS PO Box 79005 Charlotte, NC 28271-9406

LOCATION Perth, TL Fern Hill, TL 2nd Kenway Lp 1/4 mile on Rt #595 Kenway LP

SUBDIVISION DUKE BLOCK / SECTION 15 LOT 49 LOT AREA SITE CLASS. PS DESIGN FLOW 360 L.T.A.R.

Septic Tank: 1000 Gallons; STB 1012 Date 8/10/04

Pump Tank: Existing Gallons; PT Date

Pump Make: Existing Model Serial No.

Nitrification Field: No Fields Square Feet 600 Linear Feet 200 Exist

No Lines 3 Trench Width Max Trench Bottom Depth Gravel Depth 12"

☐ New System ☐ Repair System Type: I, II, III, IV, V, VI

System Description: Existing LP Conventional

Repair System Description:

Maintenance Agreement Required: ☒ Yes ☐ No

☒ House/Mod. Home No. Bedrooms 3

☐ Mobile Home No. Bathrooms 4.5

☐ Business No. Employees

☐ Other

☐ Slab ☒ Crawl Space ☒ Basement w/plumbing ☐ Basement wo/plumbing

Water Supply: ☒ Individual ☐ Public ☐ Community


Comments:/Conditions:

Kenway LP

Comments:/Conditions: Original

Change Electrical at Pump tank - Put valve Boxes at Each Valve + Turn up

INITIAL SITE SKETCH

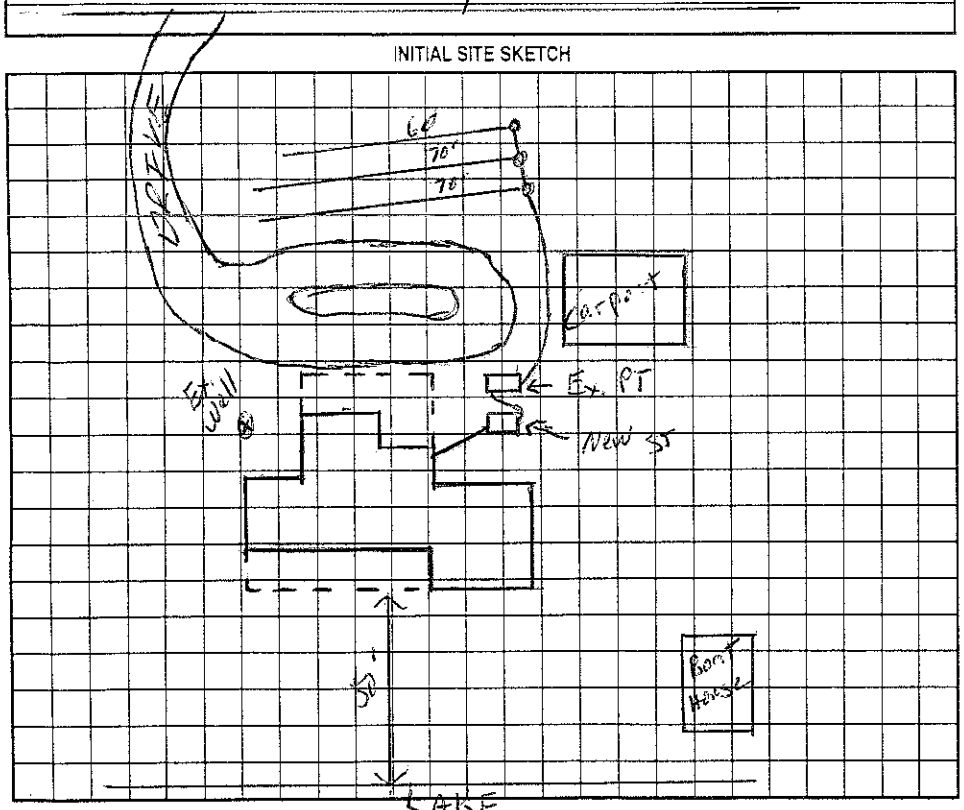

AS BUILT SKETCH

Permit can be suspended or revoked if any false information is supplied toward securing the permit/any unauthorized changes are made to the site/any unauthorized changes are made in the installation of the system. Improvement Permit with plat valid without expiration. Improvement Permit with site plan valid for sixty months. Authorization to Construct is valid for a period equal to that of Improvement Permit – not to exceed sixty months.

Signed: Dawn Profitt date

Improvement Permit by: RS date 3/10/04

Authorization to Construct by: RS date 3/10/04

Installed by: Piedmont Backhoe

Operation Permit by: RS date 2/2/05

Existing System Inspection by: date

HEALTH DEPT. COPY: WHITE OWNER COPY (FINAL): YELLOW OWNER COPY (INITIAL): PINK