IREDELL COUNTY HEALTH DEPARTMENT

STATESVILLE 704-878-5305 MOORESVILLE 704-664-5281

IMPROVEMENT PERMIT / AUTHORIZATION TO CONSTRUCT / OPERATION PERMIT / EXISTING SYSTEM INSPECTION

PERMIT# REPAIR PIN# 4638-38-2560 73 DATE 9-1-04

OWNER OR CONTRACTOR SARAH C. CRAIG PHONE: Business Home 704-537-5745

ADDRESS 5401 HICKORY GROVE ROAD CHARLOTTE, NC 28215

LOCATION FERN HILL ROAD TO 2ND KENWAY LOOP, 0.6 MILE ON RIGHT AT #579

SUBDIVISION DUKE CLT BLOCK / SECTION 15 LOT 46 LOT AREA 0.83 ACRES SITE CLASS. PS DESIGN FLOW 24 L.T.A.R. 0.30 GPD/FT²

Septic Tank: EXISTING Gallons: STB Date

Pump Tank: Gallons; PT Date

Pump Make: Model Serial No.

Nitrification Field: No Fields 1 Square Feet 450 Linear Feet 150

No Lines ONE Trench Width 36" Max Trench Bottom Depth 36" Gravel Depth 12"

☐ New System ☑ Repair System Type: I, (II), III, IV, V, VI

System Description:

Repair System Description: CONVENTIONAL, GRAVITY

Maintenance Agreement Required: ☐ Yes ☑ No

☑ House/Mod. Home No. Bedrooms 2

☐ Mobile Home No. Bathrooms

☐ Business No. Employees

☐ Other


☐ Slab ☐ Crawl Space ☑ Basement w/plumbing ☐ Basement wo/plumbing

Water Supply: ☑ Individual ☐ Public ☐ Community WELL


Comments/Conditions: INSTALL NEW DISTRIBUTION BOX AT OUTLET END OF SEPTIC TANK FEEDING OLD DRAINLINE 1ST THEN SERIALLY DOWN TO NEW DROP BOX FEEDING NEW 3'x 150' DRAINLINE ON CONTOUR AS FLAGGED

Comments/Conditions:

INITIAL SITE SKETCH

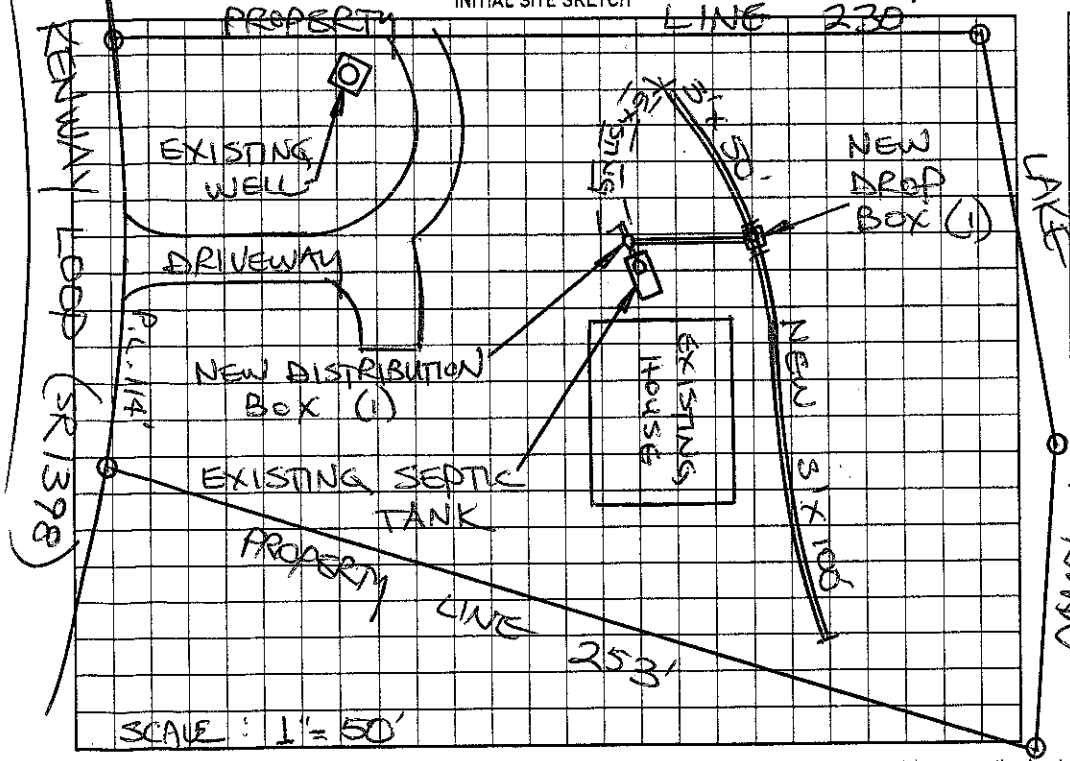

AS BUILT SKETCH

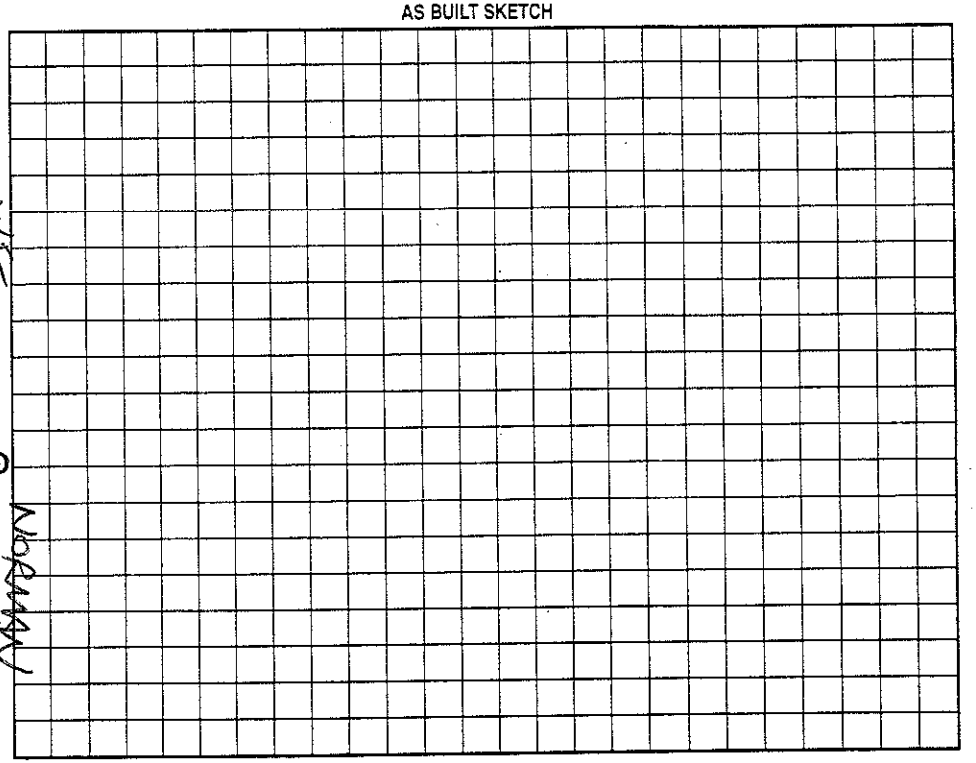

Permit can be suspended or revoked if any false information is supplied toward securing the permit/any unauthorized changes are made to the site/any unauthorized changes are made in the installation of the system. Improvement Permit with plat valid without expiration. Improvement Permit with site plan valid for sixty months. Authorization to Construct is valid for a period equal to that of Improvement Permit – not to exceed sixty months.

Signed: + Mrs. Sarah C Craig date 9.1.04

Improvement Permit by: STEVE HEDRICK date 9-1-04

Authorization to Construct by: STEVE HEDRICK date 9-1-04

Installed by: Steve Jordan

Operation Permit by: G Myers date 10/7/04

Existing System Inspection by: date

HEALTH DEPT. COPY: WHITE OWNER COPY (FINAL): YELLOW OWNER COPY (INITIAL): PINK