IREDELL COUNTY HEALTH DEPARTMENT

STATESVILLE 704-878-5305 MOORESVILLE 704-664-5281

IMPROVEMENT PERMIT / AUTHORIZATION TO CONSTRUCT / OPERATION PERMIT / EXISTING SYSTEM INSPECTION

PERMIT# 123652 PIN# 4638 39 4897 DATE 9/28/04

OWNER OR CONTRACTOR Clifford Parsons PHONE: Business 704-545-6308 Home

ADDRESS 439 Kenway Lp. Mooresville, NC. 28117

LOCATION Perth N TL Fernhill TL Bagley TR Kenway Loop

SUBDIVISION CL+T BLOCK / SECTION 15 LOT 1026 LOT AREA .89 Ac SITE CLASS PS DESIGN FLOW 360 L.T.A.R. N/A

Septic Tank: EXISTING Gallons STR Date

Pump Tank: Gallons; PT Date

Pump Make: Model Serial No.

Nitrification Field: No Fields Square Feet Linear Feet

No Lines Trench Width Max Trench Bottom Depth Gravel Depth

☐ New System ☐ Repair System Type: I, II, III, IV, V, VI

System Description:

Repair System Description: EXISTING SYSTEM

Maintenance Agreement Required: ☐ Yes ☐ No

☒ House/Mod. Home No. Bedrooms 3

☐ Mobile Home No. Bathrooms 3

☐ Business No. Employees

☐ Other

☐ Slab ☒ Crawl Space ☐ Basement w/plumbing ☐ Basement wo/plumbing


Water Supply: ☒ Individual ☐ Public ☐ Community

Comments:/Conditions:


187

Comments:/Conditions:

INITIAL SITE SKETCH

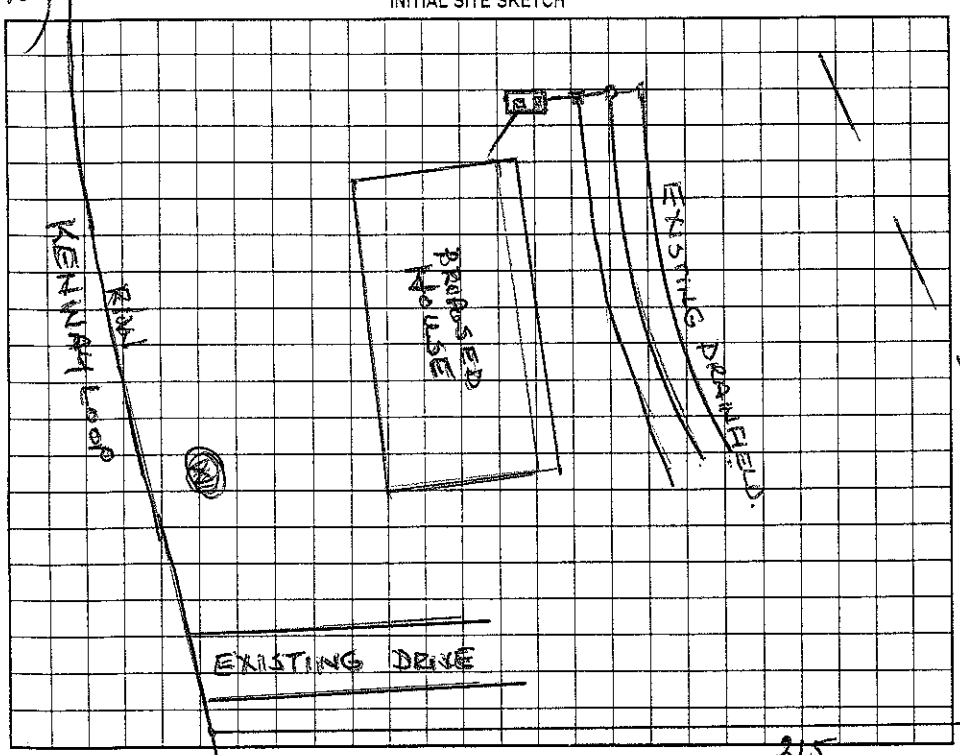

AS BUILT SKETCH

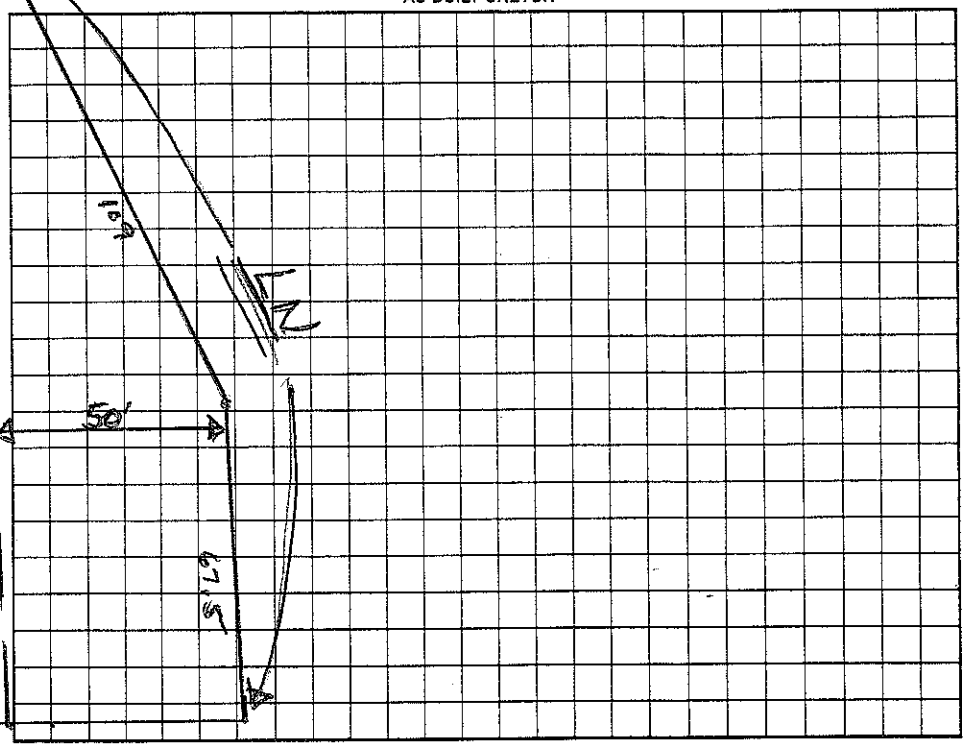

Permit can be suspended or revoked if any false information is supplied toward securing the permit/any unauthorized changes are made to the site/any unauthorized changes are made in the installation of the system. Improvement Permit with plat valid without expiration. Improvement Permit with site plan valid for sixty months. Authorization to Construct is valid for a period equal to that of Improvement Permit – not to exceed sixty months.

Signed: Clifford Parsons date: 9/29/04

Improvement Permit by: date

Authorization to Construct by: date

Installed by:

Operation Permit by: Wesley Sparks R.S. date 9/28/04

Existing System Inspection by: date

HEALTH DEPT. COPY: WHITE OWNER COPY (FINAL): YELLOW OWNER COPY (INITIAL): PINK