4638411290

IREDELL COUNTY HEALTH DEPARTMENT

STATESVILLE 704-878-5305 MOORESVILLE 704-664-5281

IMPROVEMENT PERMIT / CERTIFICATE OF COMPLETION / OPERATION PERMIT / EXISTING SYSTEM INSPECTION

PROPERTY DESCRIPTION NO. 22254 DATE 10/16/95 TAX MAP NO. 2P A 12 Watershed: ☒ Yes ☐ No

OWNER OR CONTRACTOR Timothy E Fuller PHONE: Business _____ Home LL4 - L224

ADDRESS 140 Fuller Driving Mooresville, NC. 28115

LOCATION 150 West, TR Fuller Dr. to the last trailer on (R)

SUBDIVISION N/A BLOCK / SECTION _____ LOT _____ LOT AREA _____ SITE CLASS. _____ DESIGN FLOW 360 L.T.A.R. _____

Septic Tank: Existing System Gallons; STB _____ Date _____

Pump Tank: _____ Gallons; PT _____ Date _____

Pump Make: _____ Model _____ Serial No. _____

Nitrification Field: No Fields ____ Square Feet _____ Linear Feet _____

No Lines _____ Trench Width _____ Max Trench Bottom Depth _____ Gravel Depth _____

☐ New System ☐ Repair System Type: I, II, III, IV, V, VI

System Description: Existing System

Repair System Description: _____

Maintenance Agreement Required: ☐ Yes ☒ No

☐ House/Mod. Home No. Bedrooms 3

☒ Mobile Home No. Bathrooms 2

☐ Business No. Employees ____

☐ Other _____


☐ Slab ☐ Crawl Space ☐ Basement w/plumbing ☐ Basement wo/plumbing

Water Supply:
☒ Individual
☐ Community
☐ Public


Comments:

Comments: Existing System

INITIAL SITE SKETCH

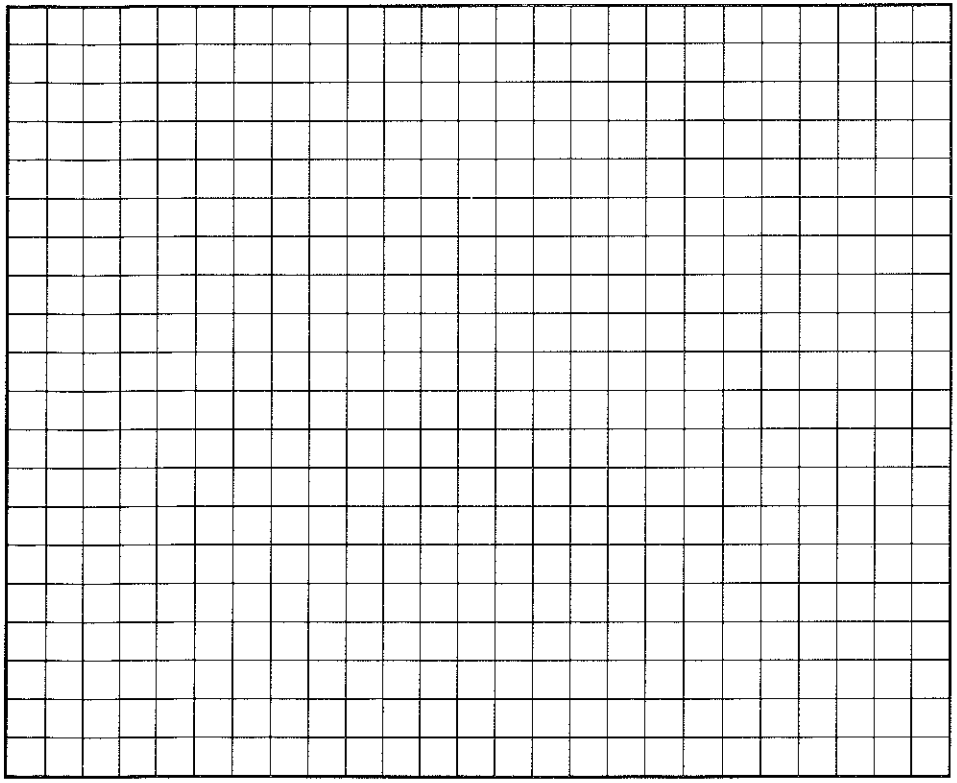

AS BUILT SKETCH

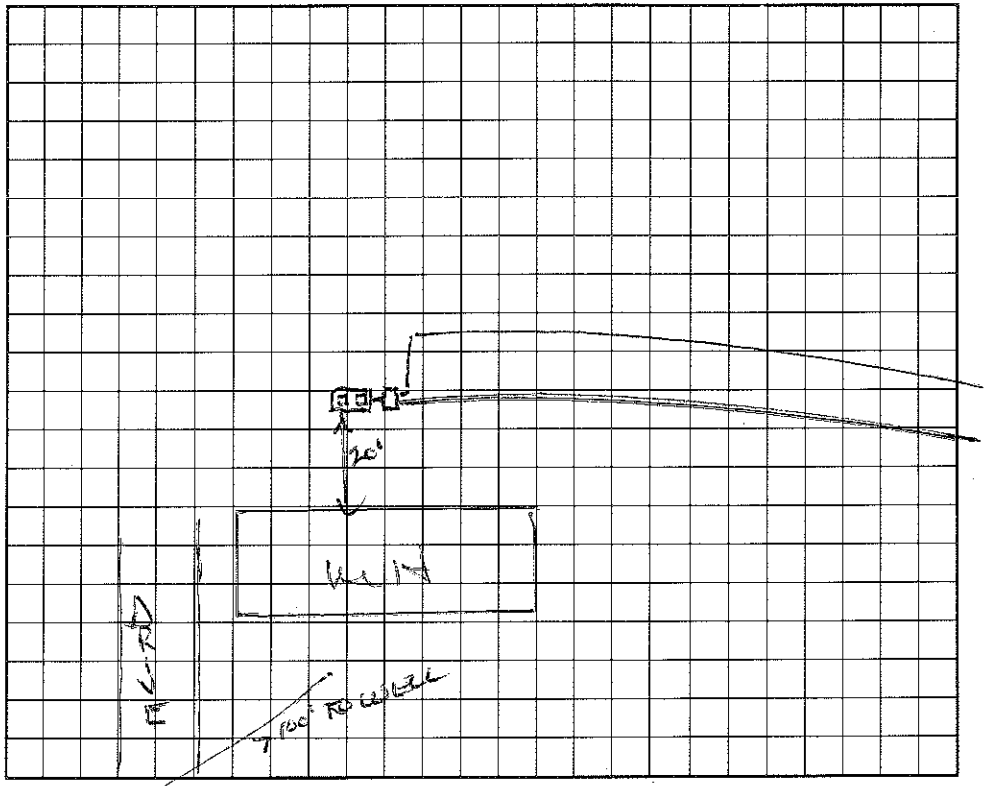

I understand that this permit can be suspended or revoked if any false information is supplied toward securing the permit/any unauthorized changes are made to the site/any unauthorized changes are made in the installation of the system.

Signed: _____ Installed by: _____

Improvement Permit by: _____ date _____ Certificate of Completion by: _____ date _____

Existing System Inspection by: Wesley Sparks R.S. date 10/16/95 Operation Permit by: _____ date _____

HEALTH DEPT. COPY: WHITE INSPECTION COPY (FINAL): GREEN OWNER COPY (FINAL): YELLOW INSPECTION COPY (INITIAL): PINK OWNER COPY (INITIAL): GOLD