# IREDELL COUNTY HEALTH DEPARTMENT

STATESVILLE 704-878-5305 MOORESVILLE 704-664-5281

## IMPROVEMENT PERMIT / AUTHORIZATION TO CONSTRUCT / OPERATION PERMIT / EXISTING SYSTEM INSPECTION

Sunny 90's - 2000 4100 ft

PERMIT# 06918 PIN# 4638424705 Pt of 4638-42-3858 Cell DATE 6/7/2000

OWNER OR CONTRACTOR Crescent Resources / Prestige Building PHONE: Business 528-3999 ~~Home~~ 363-4849

ADDRESS P.O. Box 749 Troutman, NC 28166

LOCATION Perth Rd TL Normandy Rd TR McNaron Ln

SUBDIVISION CL&T BLOCK / SECTION ____ LOT 102B LOT AREA .767 Acre SITE CLASS. PS DESIGN FLOW 360gpd L.T.A.R. .3

Septic Tank: 1000 Gallons; STB RST825 Date 3/11/00
Pump Tank: 1000 Gallons; PT 302 Date 5/11/00
Pump Make: Hydromatic Model SH50/A Serial No. ____
Nitrification Field: No Fields 1 Square Feet 300' Linear Feet 900'
No Lines 4 at 75' Trench Width 36" Max Trench Bottom Depth 36" Gravel Depth N/A

☒ New System ☐ Repair System Type: I, II, III, IV, V, VI
System Description: Pump-PM-25% Reduction
Repair System Description: Pump Panel
Maintenance Agreement Required: ☐ Yes ☒ No


☒ House/Mod. Home ☐ Mobile Home ☐ Business ☐ Other
No. Bedrooms 3 No. Bathrooms 3 No. Employees ____
☐ Slab ☐ Crawl Space ☒ Basement w/plumbing ☐ Basement wo/plumbing

Water Supply: ☒ Individual ☐ Public ☐ Community

Comments:/Conditions: Keep Septic System 16' From PL, 25' (upgradient) of basement wall, 50' from lake & 50' from well Lake Norman

Comments:/Conditions: Replaces permit issued 8/26/97
Lines checked 8/14/00 MD
Supply line exactly 50' from neighbor's well
Well Not installed at time of inspection

INITIAL SITE SKETCH

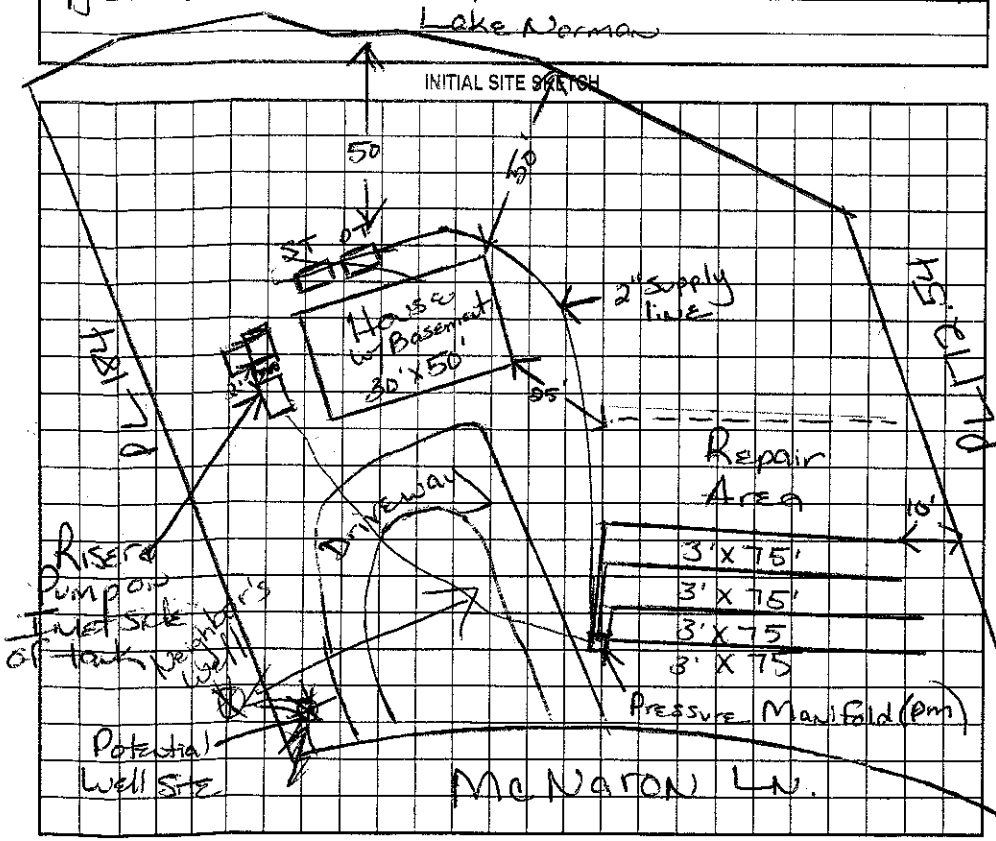


AS BUILT SKETCH

Permit can be suspended or revoked if any false information is supplied toward securing the permit/any unauthorized changes are made to the site/any unauthorized changes are made in the installation of the system. Improvement Permit with plat valid without expiration. Improvement Permit with site plan valid for sixty months. Authorization to Construct is valid for a period equal to that of Improvement Permit – not to exceed sixty months.

Signed: K. W. Troutman date 6/7/00 Installed by: C & W Grading

Improvement Permit by: Maria H. Dotson RS. date 6/7/2000 Operation Permit by: Maria H. Dotson RS date 2/13/2001

Authorization to Construct by: Maria H. Dotson RS. date 6/7/2000 Existing System Inspection by: ____ date ____

HEALTH DEPT. COPY: WHITE OWNER COPY (FINAL): YELLOW OWNER COPY (INITIAL): PINK