IREDELL COUNTY HEALTH DEPARTMENT

STATESVILLE 704-878-5305 MOORESVILLE 704-664-5281

IMPROVEMENT PERMIT / CERTIFICATE OF COMPLETION / OPERATION PERMIT / EXISTING SYSTEM INSPECTION

PROPERTY DESCRIPTION NO. 17199 DATE 11/4/93 TAX MAP NO. 2P 4 A 116 Watershed: ☑ Yes ☐ No

OWNER OR CONTRACTOR BARRY MORRIS PHONE: Business 663-7803 Home

ADDRESS R+8 BOX 651 E MOORESVILLE, NC 4658-43-1618

LOCATION NORMANDY RD, TR GRAVEL PAST KEENAN RD. TO CHAIN LOT AT END DIRECTLY AHEAD

SUBDIVISION CL + T BLOCK / SECTION 11 LOT 116 LOT AREA 1.1 AC SITE CLASS. P DESIGN FLOW 360 L.T.A.R. .25 - .3

Septic Tank: 1000 Gallons; ST B ~~ES~~ 338 Date 1/24/94

Pump Tank: 1000 Gallons; PT 103 Date 1/21/94

Pump Make: _____ Model _____ Serial No. _____

Nitrification Field: No Fields 1 Square Feet 1200 Linear Feet 420

No Lines 6 Trench Width 3' Max Trench Bottom Depth 30" Gravel Depth 12"

☐ New System ☐ Repair System Type: I, II, III, IV, V, VI

System Description: PRES - CONVENTIONAL

Repair System Description: _____

Maintenance Agreement Required: ☑ Yes ☐ No

☑ House/Mod. Home No. Bedrooms 3

☐ Mobile Home No. Bathrooms 2

☐ Business No. Employees _____

☐ Other _____


☐ Slab ☑ Crawl Space ☐ Basement w/plumbing ☐ Basement wo/plumbing

Water Supply: ☑ Individual ☐ Community ☐ Public

Comments: 1 1/2 PVC - 3/16" HOLE ON 5' CNTRS - TURN HOLES UP OR SLEEVE IN 4 INCH PERFORATED PIPE - 30" TRENCH BOTTOM

Comments:

INITIAL SITE SKETCH

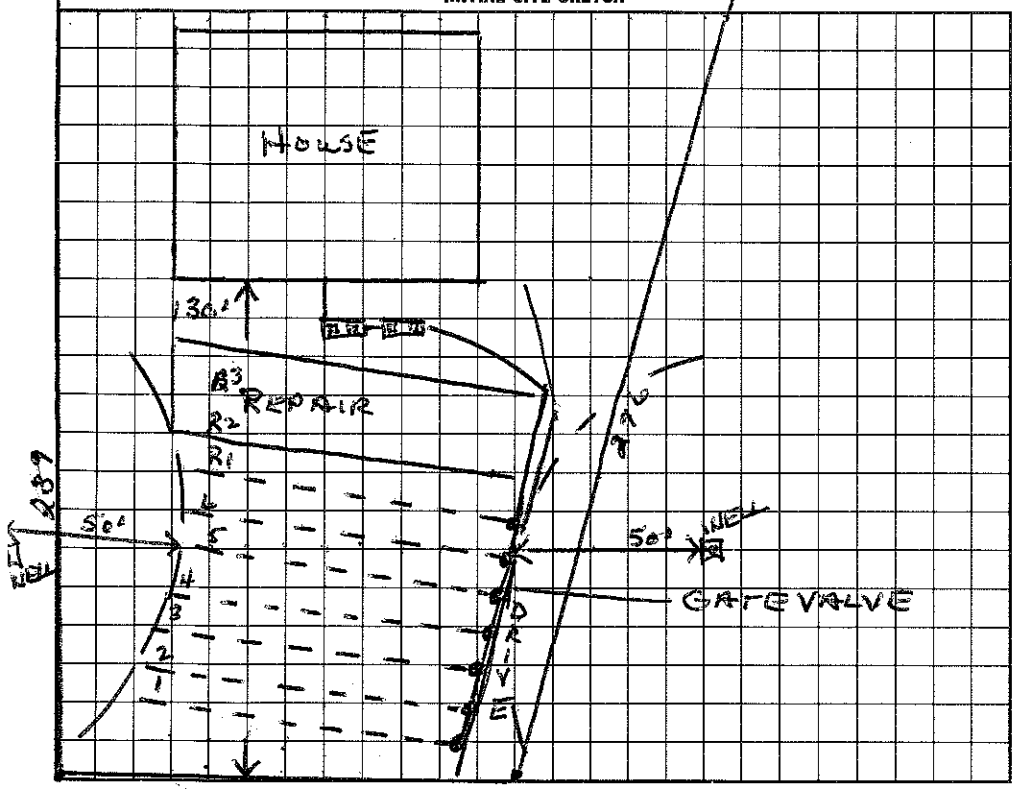

AS BUILT SKETCH

I understand that this permit can be suspended or revoked if any false information is supplied toward securing the permit/any unauthorized changes are made to the site/any unauthorized changes are made in the installation of the system. Improvement Permit is valid for 60 months from date of issuance.

Signed: Thornton Brooks

Improvement Permit by: Wesley Sparks R.S. date 11/4/93

Existing System Inspection by: _____ date _____

Installed by: Barry Morris

Certificate of Completion by: Wesley Sparks R.S. date 4/28/94

Operation Permit by: Wesley Sparks R.S. date 4/28/94

HEALTH DEPT. COPY: WHITE INSPECTION COPY (FINAL): GREEN OWNER COPY (FINAL): YELLOW INSPECTION COPY (INITIAL): PINK OWNER COPY (INITIAL): GOLD