IREDELL COUNTY HEALTH DEPARTMENT

AUTHORIZATION TO CONSTRUCT

STATESVILLE 704-878-5305 MOORESVILLE 704-664-5281

IMPROVEMENT PERMIT / ~~CERTIFICATE OF COMPLETION~~ / OPERATION PERMIT / EXISTING SYSTEM INSPECT

PROPERTY DESCRIPTION NO. 24534 DATE 7/23/97 TAX MAP NO. 2P-4-A-189 4638 43 8541 Watershed: ☐ ~~Yes~~

OWNER OR CONTRACTOR LOUIS A BURTON PHONE: Business _____ Home 875-1230

ADDRESS 15216 OLD STATESVILLE RD - MOORESVILLE

LOCATION PERTH RD - TL NORMANDY - CORNER OF NORMANDY AND DOOLITTLE ON LEFT

SUBDIVISION LNAP BLOCK / SECTION 2 LOT 15 & 32 LOT AREA 1.21 AC SITE CLASS. PS DESIGN FLOW 480 GPD L.T.A.R. .3

Septic Tank: 1000 Gallons; STB 1012 Date 5/18/97

Pump Tank: 1000 Gallons; PT 17 Date 6/18/97

Pump Make: _____ Model _____ Serial No. _____

Nitrification Field: No Fields 1 Square Feet 540 Linear Feet 270

No Lines 6@45' Trench Width 24" Max Trench Bottom Depth 36" Gravel Depth N/A

☑ New System ☐ Repair System Type: I, II, III, IV, V, VI

System Description: PUMP PANEL

Repair System Description: SAME

Maintenance Agreement Required: ☐ Yes ☑ No

☑ House/Mod. Home No. Bedrooms 4

☐ Mobile Home No. Bathrooms 3

☐ Business No. Employees ____

☐ Other _____


☐ Slab ☑ Crawl Space ☑ Basement w/plumbing ☐ Basement wo/plumbing

Water Supply:
☑ Individual
☐ Community
☐ Public

Comments:

Comments: PARTIAL

INITIAL SITE SKETCH

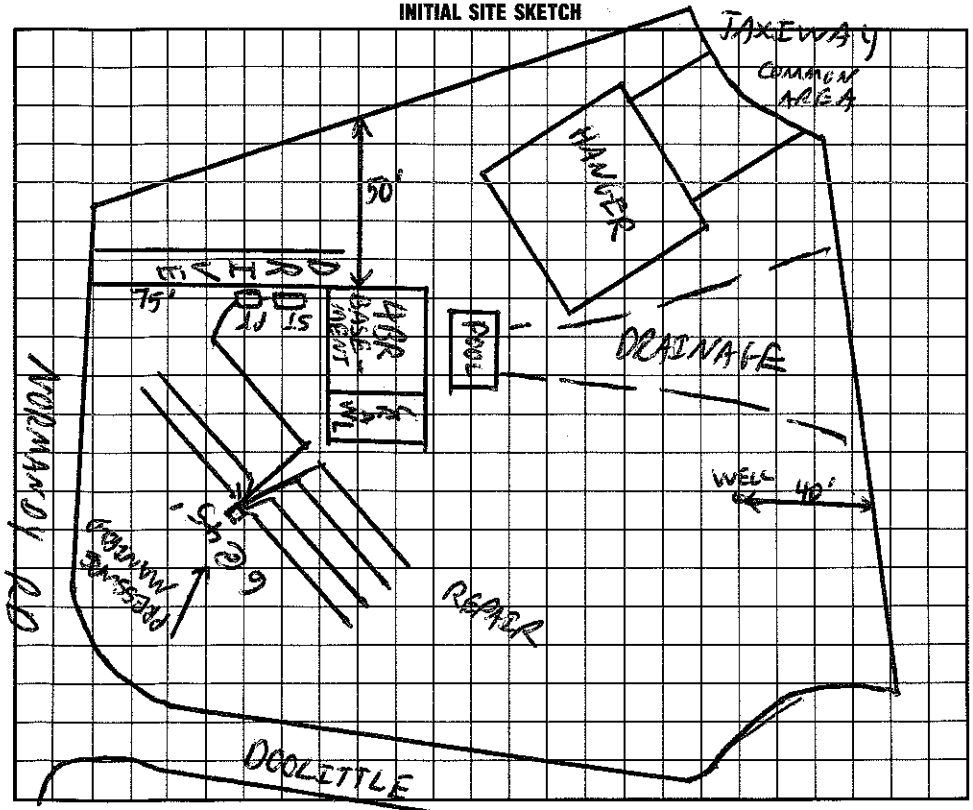

AS BUILT SKETCH

I understand that this permit can be suspended or ~~revoked~~ if any false information is supplied toward securing the permit/any unauthorized changes are made to the site/any unauthorized changes are made in the installation of the system. Improvement Permit is valid for 60 months from date of issuance.

Signed: _____

Improvement Permit by: C. Rob Zoeller date 7/23/97

AUTHORIZATION TO CONSTRUCT ~~Existing System Inspection by:~~ C. Rob Zoeller date 7/23/97

Installed by: Tommy Cauthen Backhoe

Certificate of Completion by: Wesley Sparkman date 3/18/98

Operation Permit by: Wesley Sparkman date 3/18/98

HEALTH DEPT. COPY: WHITE INSPECTION COPY (FINAL): GREEN OWNER COPY (FINAL): YELLOW INSPECTION COPY (INITIAL): PINK OWNER COPY (INITIAL): GOLD