1:30-2:00

IREDELL COUNTY HEALTH DEPARTMENT

STATESVILLE 704-878-5305 MOORESVILLE 704-664-5281

IMPROVEMENT PERMIT / AUTHORIZATION TO CONSTRUCT / OPERATION PERMIT / EXISTING SYSTEM INSPECTION

PERMIT# 22733 PIN# 2P 4 A 150 4638-43-8876 DATE 2/28/00

OWNER OR CONTRACTOR RONALD SZOT PHONE: Business Home

ADDRESS 4015 MEANDERING WAY

LOCATION HWY 150 - TR PERTH - TL NORMANDY RD - TL AMELIA - LOT AT END

SUBDIVISION ~~CR~~ LAKE BLOCK / SECTION 2 LOT 30 LOT AREA 1 AC SITE CLASS PS DESIGN FLOW ~~300~~ 360 L.T.A.R. .35 gal/ft²

Septic Tank: 1000 Gallons; STB 975 Date 10-9-00
Pump Tank: Gallons; PT Date
Pump Make: Model Serial No.
Nitrification Field: No Fields 1 Square Feet 1200 Linear Feet 400
No Lines 5@80' Trench Width 36" Max Trench Bottom Depth 24" Gravel Depth N/A

☑ New System ☐ Repair System Type: I (II) III, IV, V, VI
System Description: GRAVITY CONVENTIONAL
Repair System Description: GRAV/ 75% REDUCTION
Maintenance Agreement Required: ☐ Yes ☑ No

☑ House/Mod. Home No. Bedrooms 3
☐ Mobile Home No. Bathrooms 3
☐ Business No. Employees
☐ Other
☐ Slab ☑ Crawl Space ☐ Basement w/plumbing ☐ Basement wo/plumbing


Water Supply: ☑ Individual ☐ Public ☐ Community

Comments:/Conditions:


NO SCALE

Comments:/Conditions: Filter installed

INITIAL SITE SKETCH

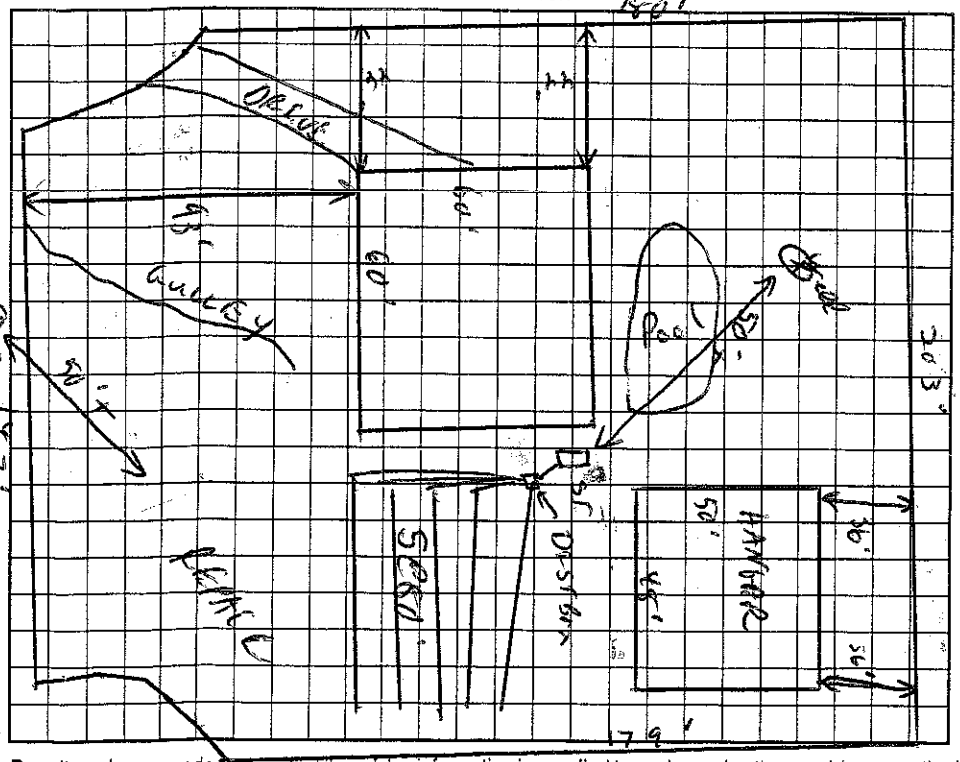

AS BUILT SKETCH

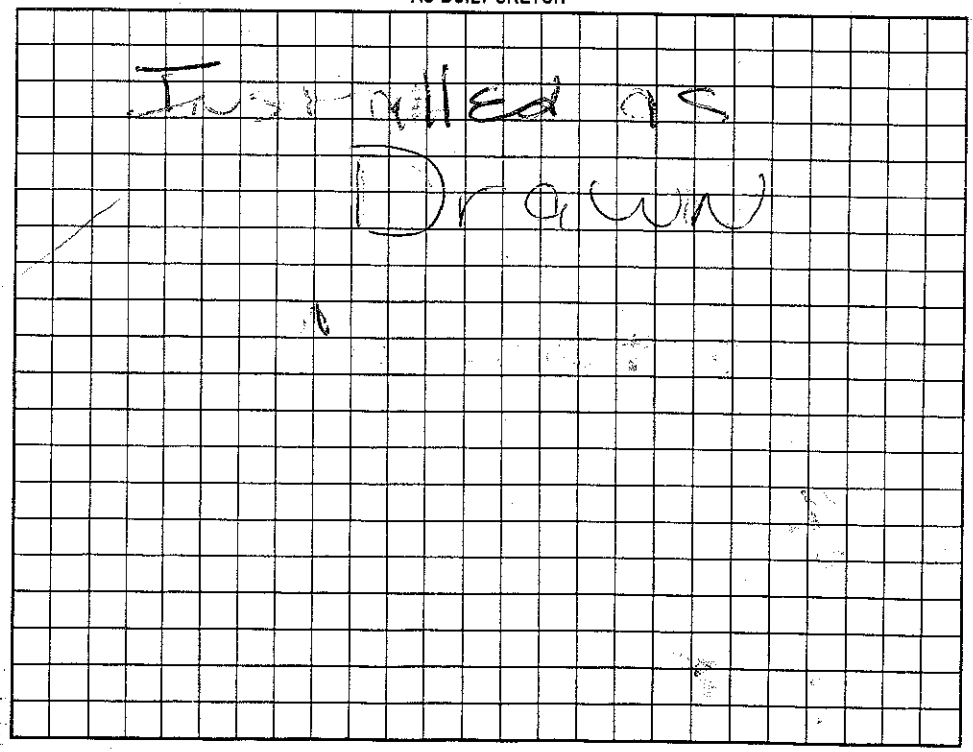

Permit can be suspended or revoked if any false information is supplied toward securing the permit/any unauthorized changes are made to the site/any unauthorized changes are made in the installation of the system. Improvement Permit with plat valid without expiration. Improvement Permit with site plan valid for sixty months. Authorization to Construct is valid for a period equal to that of Improvement Permit – not to exceed sixty months.

Signed: Charles W Stevens date 3-13-00 Installed by: W. T. Darnell

Improvement Permit by: ES date 2/28/00 Operation Permit by: Maria H Oliver date 11/16/2000

Authorization to Construct by: ES date 2/28/00 Existing System Inspection by: date

HEALTH DEPT. COPY: WHITE OWNER COPY (FINAL): YELLOW OWNER COPY (INITIAL): PINK