AUTHORIZATION TO CONSTRUCT

IREDELL COUNTY HEALTH DEPARTMENT

STATESVILLE 704-878-5305 MOORESVILLE 704-664-5281

IMPROVEMENT PERMIT / ~~CERTIFICATE OF COMPLETION~~ / OPERATION PERMIT / EXISTING SYSTEM INSPECTION

PROPERTY DESCRIPTION NO. 22122 DATE 10/2/95 TAX MAP NO. 2P 4A 35 Watershed: [X] Yes [ ] No

OWNER OR CONTRACTOR John Schroeder PHONE: Business 202-336-7489 ~~Home~~ 4638-43-9274

ADDRESS 4628 Arlington Blvd. Arlington Va. 22204-1341

LOCATION LNAP, Normandy Rd. TL Doolittle lot on (R) corner

SUBDIVISION LNAIRPARK BLOCK / SECTION ____ LOT 35 LOT AREA ~1.6AC SITE CLASS. P.S DESIGN FLOW 480 L.T.A.R. .35

Septic Tank: 1600 Gallons; STB 1011 Date 9/24/98
Pump Tank: ____ Gallons; PT ____ Date ____
Pump Make: ____ Model ____ Serial No. ____
Nitrification Field: No Fields 1 Square Feet 1371 Linear Feet 457
No Lines 4 Trench Width 36" Max Trench Bottom Depth 36" Gravel Depth 12"

[X] New System [ ] Repair System Type: I, [II] III, IV, V, VI
System Description: GRAVITY CONVENTIONAL
Repair System Description: SAME
Maintenance Agreement Required: [ ] Yes [X] No


[X] House/Mod. Home No. Bedrooms 4
[ ] Mobile Home No. Bathrooms 3.5
[ ] Business No. Employees ____
[ ] Other ____
[ ] Slab [ ] Crawl Space [X] Basement w/plumbing [ ] Basement wo/plumbing

Water Supply:
[X] Individual
[ ] Community
[ ] Public


Comments: TO 11-4-1998

Comments:

INITIAL SITE SKETCH

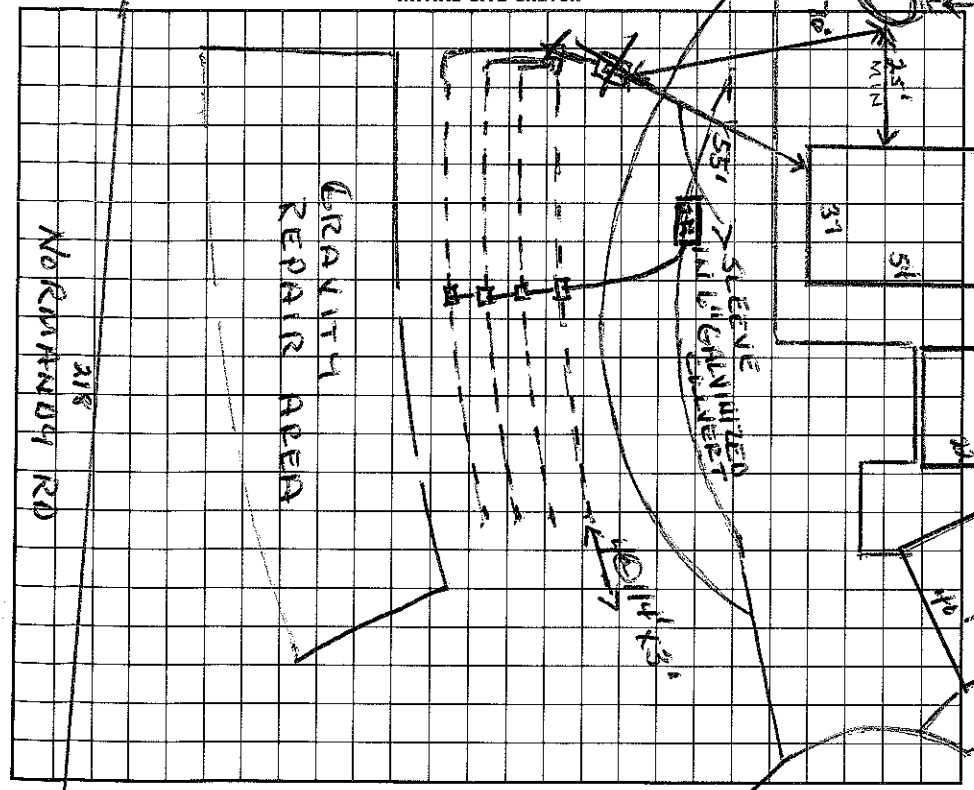

AS BUILT SKETCH

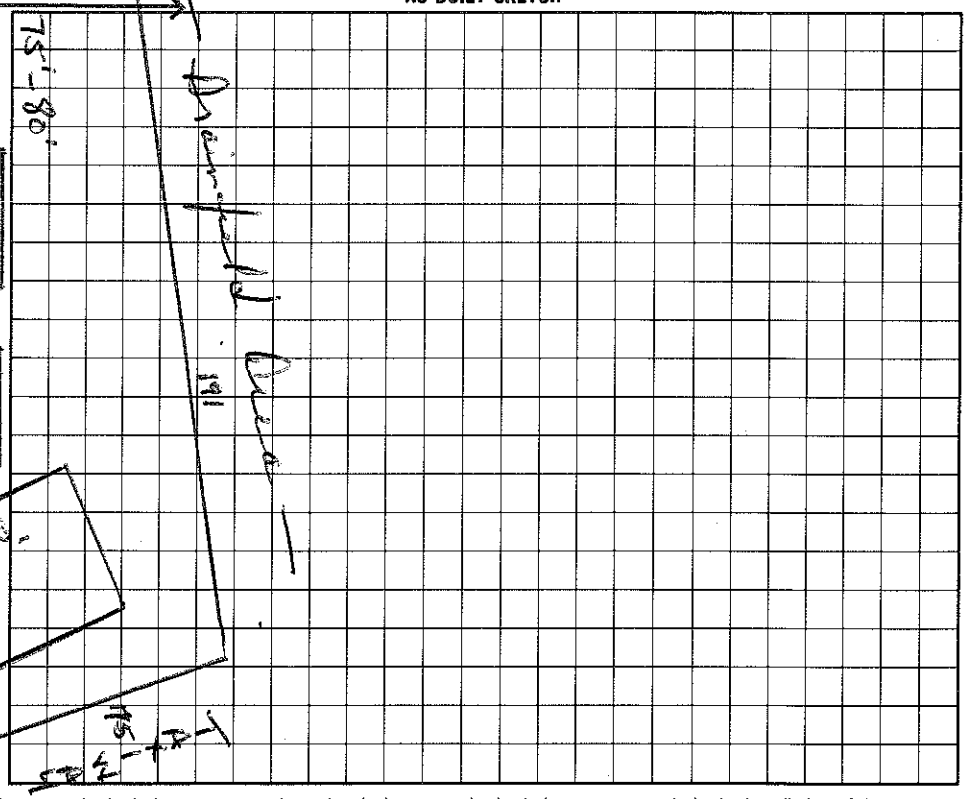

I understand that this permit can be suspended or revoked if any false information is supplied toward securing the permit/any unauthorized changes are made to the site/any unauthorized changes are made in the installation of the system.

AUTHORIZATION TO CONSTRUCT VALID FOR 5 YRS. FROM ISSUE DATE.

Signed: Keith Ellington Agent

Improvement Permit by: Wesley Sparks R.S. date 10/2/95

AUTHORIZATION CONSTRUCT Existing System Inspection by: Wesley Sparks R.S. date 10/2/95

Installed by: Forest Shuford

EXISTING SYSTEM Certificate of Completion by: Wesley Sparks R.S. date 2/25/98

Operation Permit by: Wesley Sparks R.S. date 2/25/98

HEALTH DEPT. COPY: WHITE INSPECTION COPY (FINAL): GREEN OWNER COPY (FINAL): YELLOW INSPECTION COPY (INITIAL): PINK OWNER COPY (INITIAL): GOLD