# IREDELL COUNTY HEALTH DEPARTMENT

STATESVILLE 704-878-5305 130.00 paid MOORESVILLE 704-664-5281

## IMPROVEMENT PERMIT / AUTHORIZATION TO CONSTRUCT / OPERATION PERMIT / EXISTING SYSTEM INSPECTION

PERMIT# 113021 PIN# 4638 44 0798 DATE 9/5/03

OWNER OR CONTRACTOR Terry Davies PHONE: Business 704-663-1600 Home

ADDRESS 514 Williamson Rd. Ste. 421 Mooresville, NC. 28117

LOCATION 150 N TR Perth Rd. TL Normandy Rd. on (L) near Kenen Dr. intersection

SUBDIVISION LN AIRPARK BLOCK / SECTION 1 LOT 23 LOT AREA ~1.8A~ SITE CLASS. PS DESIGN FLOW 480 L.T.A.R. .3

Septic Tank: 1000 Gallons; STB 794 Date 2/24/05
Pump Tank: 1000 Gallons; PT 27 Date 6/24/05
Pump Make: Liberty Model ~~ESS~~ Serial No. 10"
Nitrification Field: No Fields 1 Square Feet 1200 Linear Feet 400
No Lines 4 @ 100' Trench Width 3' Max Trench Bottom Depth 3'

[X] New System [ ] Repair System Type: I, II, (III) IV, V, VI
System Description: Pres. Manifold to Type 3
Repair System Description: Same
Maintenance Agreement Required: [ ] Yes [X] No

[X] House/Mod. Home No. Bedrooms 4
[ ] Mobile Home No. Bathrooms 4
[ ] Business No. Employees
[ ] Other

Water Supply: [X] Individual [ ] Public [ ] Community


Gravel Depth N/A [X] Slab [ ] Crawl Space [ ] Basement w/plumbing [ ] Basement wo/plumbing

Comments/Conditions: Zoe Ln 140 shortened

Comments/Conditions: 2 2 Flow shortened

1" = 100'

INITIAL SITE SKETCH

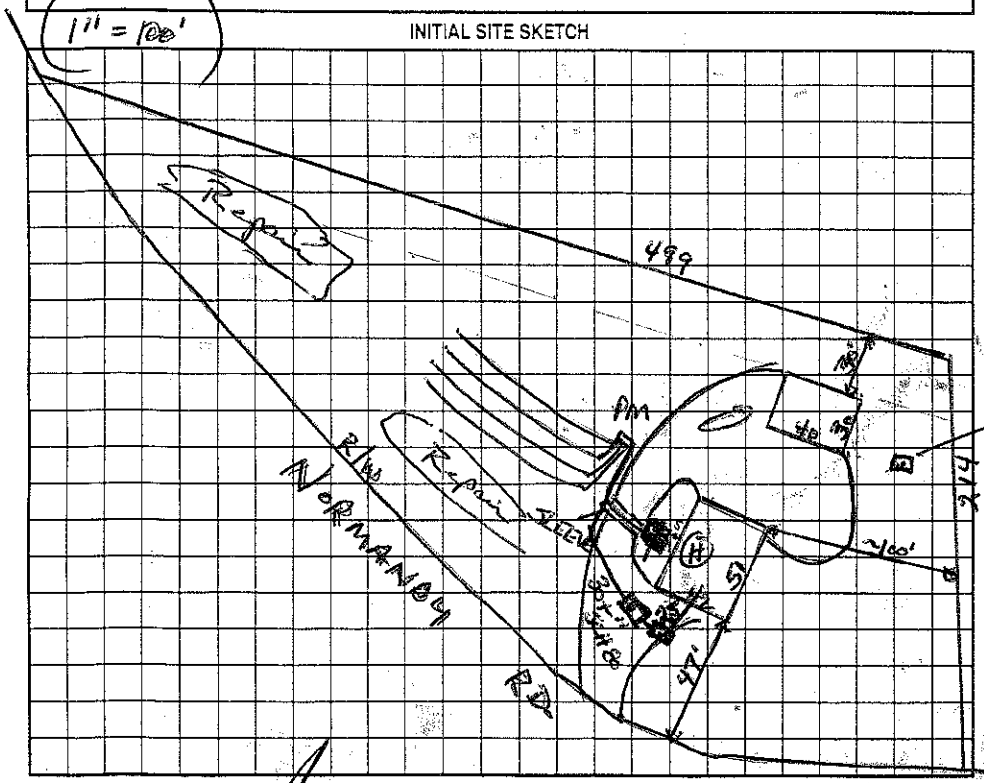


AS BUILT SKETCH

Permit can be suspended or revoked if any false information is supplied toward securing the permit/any unauthorized changes are made to the site/any unauthorized changes are made in the installation of the system. Improvement Permit with plat valid without expiration. Improvement Permit with site plan valid for sixty months. Authorization to Construct is valid for a period equal to that of Improvement Permit – not to exceed sixty months.

Signed: X date 9-10-03 Installed by: V&T Norwood N. Wade

Improvement Permit by: Wesley Sparks RS. date 9/5/03 Operation Permit by: Wesley Sparks RS date 9/22/05

Authorization to Construct by: Wesley Sparks RS date 8/17/04 Existing System Inspection by: date

HEALTH DEPT. COPY: WHITE OWNER COPY (FINAL): YELLOW OWNER COPY (INITIAL): PINK